

No. 326


213

the $\frac{1}{2}$ of the
S.E. $\frac{1}{4}$ of Sec.
the 4th T. 21 N.

Survey made for Robt Templeton of the S.E. $\frac{1}{4}$ of
S.E. $\frac{1}{4}$ of Sec. 25 in Town 4, Range 5 of Grant Co. W. T.

1755 E
D
E
F
Bearing of misplacing these corners 113

M. S. 697 E. 71
do. 12. 1. 597 N. 45
C. 115
B. 12. 1. 77 N. 23
do. 8. 1. 57 N. 29

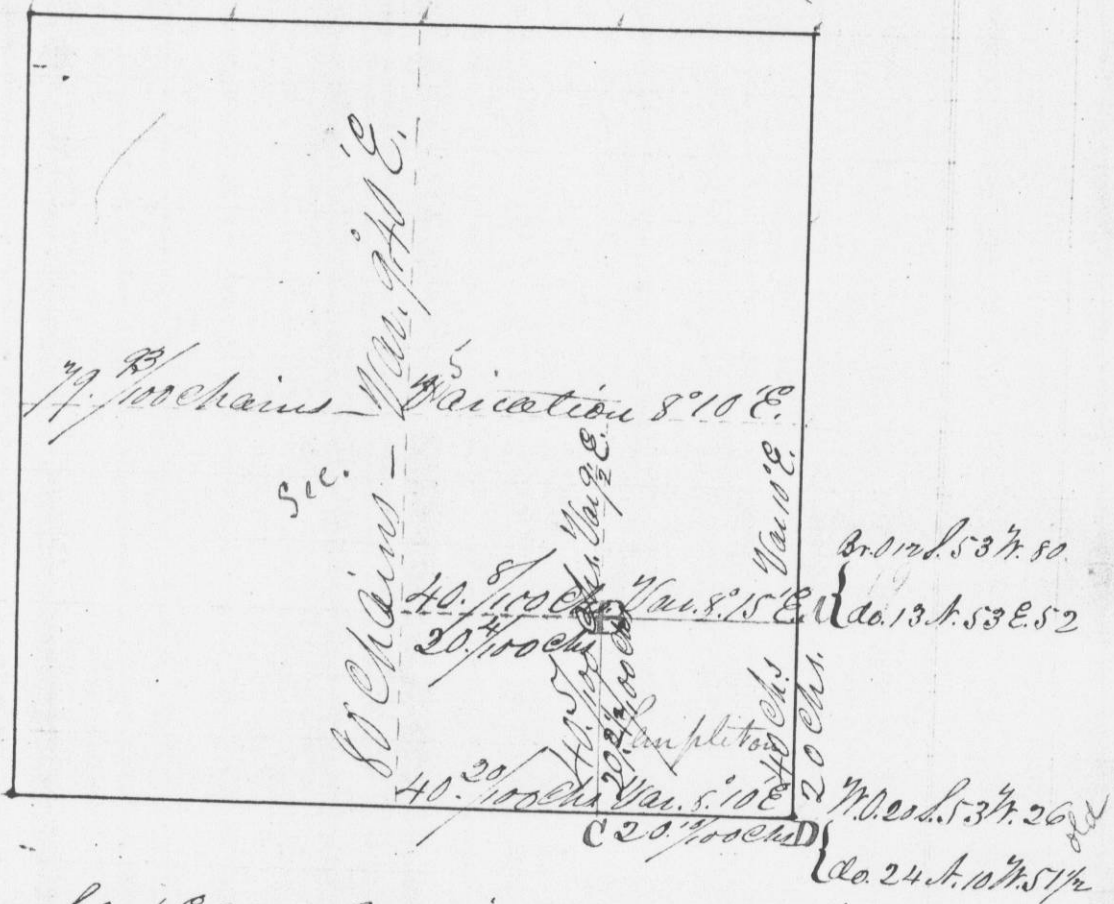

Bearings Br. C. 10 S. 82 1/2 E 99 } Bearings B. 12 N. 77 W. 23
at B } no other near } at C } do 8 S. 59 W. 29

No. 20. 1. 43 E.
do. 15. 1. 58 N. 10 E.
44

I hereby certify that the above is a True
record, ~~made~~ of said survey, made Apr. 22

H. A. Wittse
Dist. Surveyor of
Grant Co. W. T.

True record
Dist. Sur. of G. Co. W. T.