


Survey made for J. S. Woodruff of the E 1/2
of S.W. 1/4 of Sec. 18, in T4. Range 4 in Grant
County, Wisconsin

Survey made
of the N.E. 1/4
Range 3 West

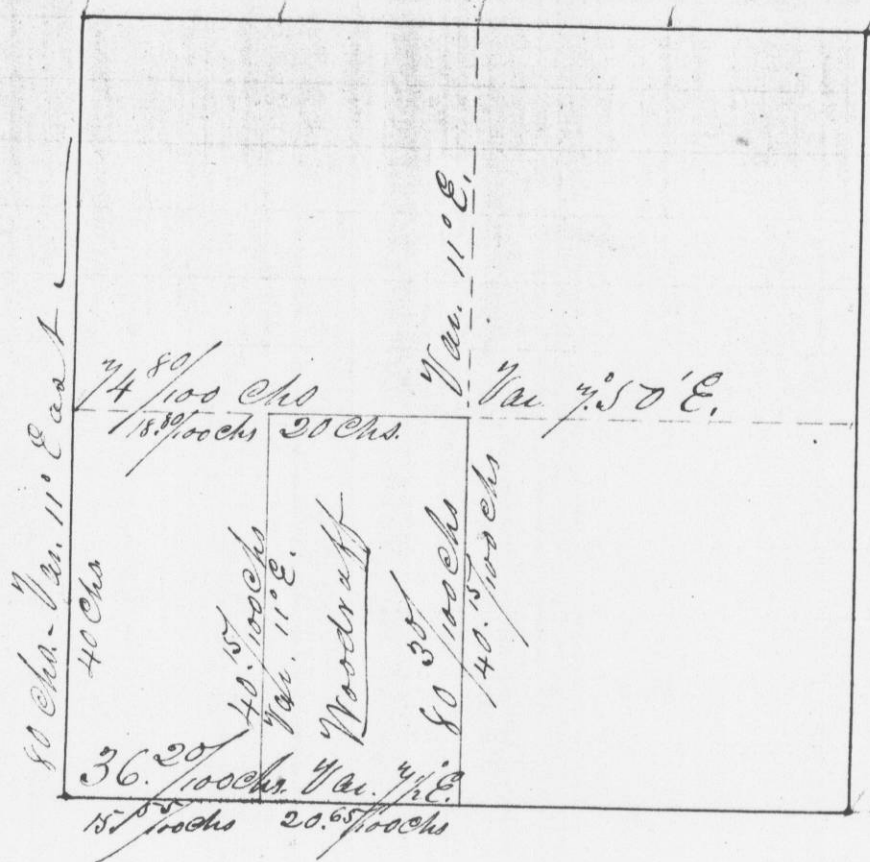

All the corners of the said Tract are Posts in Grounds.
I hereby certify that the above is a
True record of said Survey, made July 19th, 1844.
H. A. Wilcox
Dist. Surveyor of
Grant Co. Wis.

Range, R. 11
T. 4 N. 10
and of said