
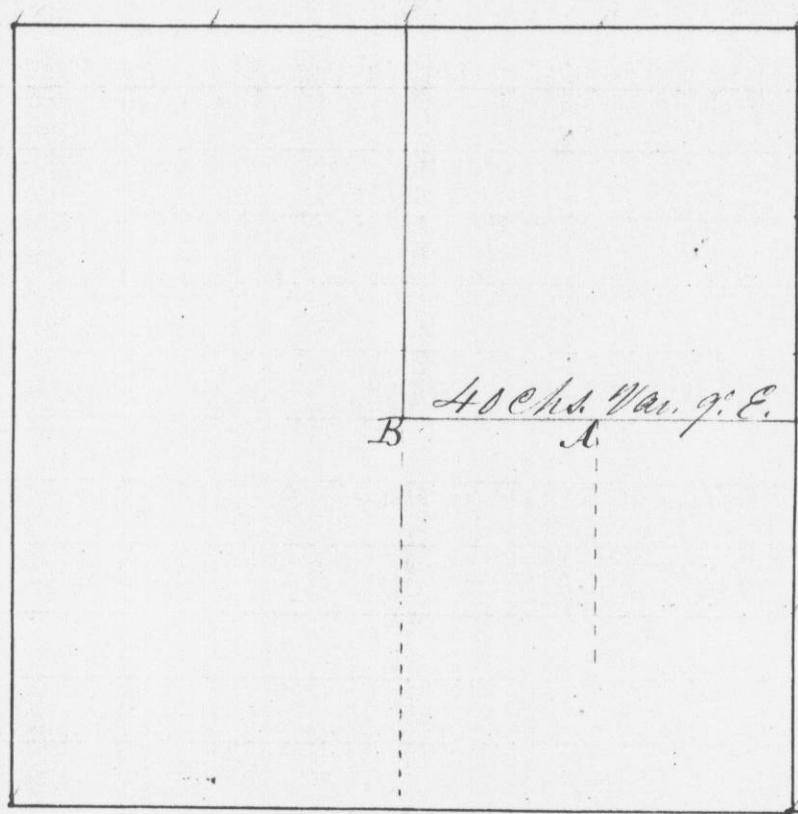


W of the E 1/4

Survey made for Joseph Wolley & Robt. Templeton

of the N. E. 1/4 of Section 5, in Town 2 North, in

Range 3 West of the 4th P.M. in Grant Co. W.T.

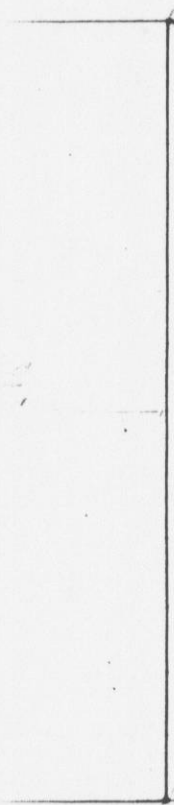

see Posts in memo. ds.

the above is a

July 19th. 1844

A. Wiltse

Surveyor of

W. T.

| | | | |
|---------|--|---------|--------------------|
| Bearing | Pin 0. 10 S 70 ¹ / ₂ E 109 | Bearing | 9 |
| at A | do. 60. 40 E. 25 | at B | { No. 18. 22 N. 94 |

I hereby certify that the above is a true record of said Survey, made Apr. 29th 1844
 A. Wiltse
 Dist. Sur. of W. T.