


331

Survey made for Aey Cole of the  
N<sup>1</sup>/<sub>2</sub> of the N<sup>1</sup>/<sub>2</sub> of Section 12  
T. 1. R. 2. 4<sup>th</sup> P. Meri-

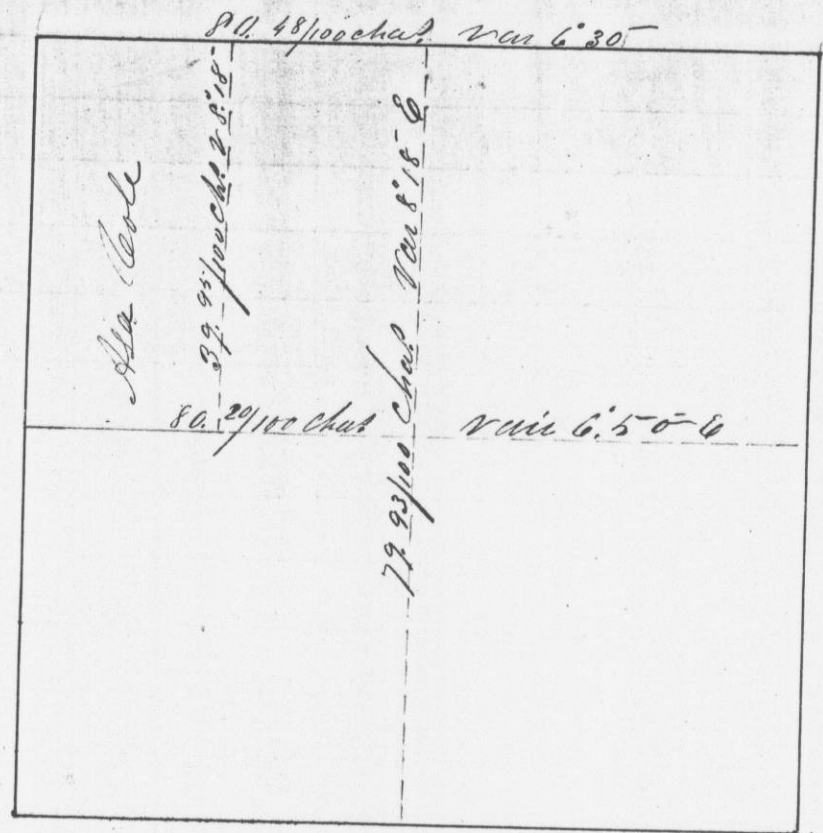

Covers all Parts set in bounds  
I hereby certify that the above  
is a true Plat & Copy of the minutes of  
said Survey made by me the 24<sup>th</sup> of April  
1844

Saml. C. Wilton  
Deft Dist. Surveyor  
Grant Co. W. V.

Survey  
of the S<sup>1</sup>/<sub>2</sub>  
of the S<sup>1</sup>/<sub>2</sub>  
4<sup>th</sup> P. Meri-



Covers  
I have  
platt  
made