


No 334

221

Plan name of  
T. N. R. W.  
S. E. 1/4 of Sect

Survey made for Huncan Cope & Thomas  
& Taylor of the N 1/2 & the N 1/2 of the S E 1/4  
of Section 1 of T. N. R. 2 W. of the 4<sup>th</sup> P. Meridian  
S. 0. 4/100 Chas var 8:30

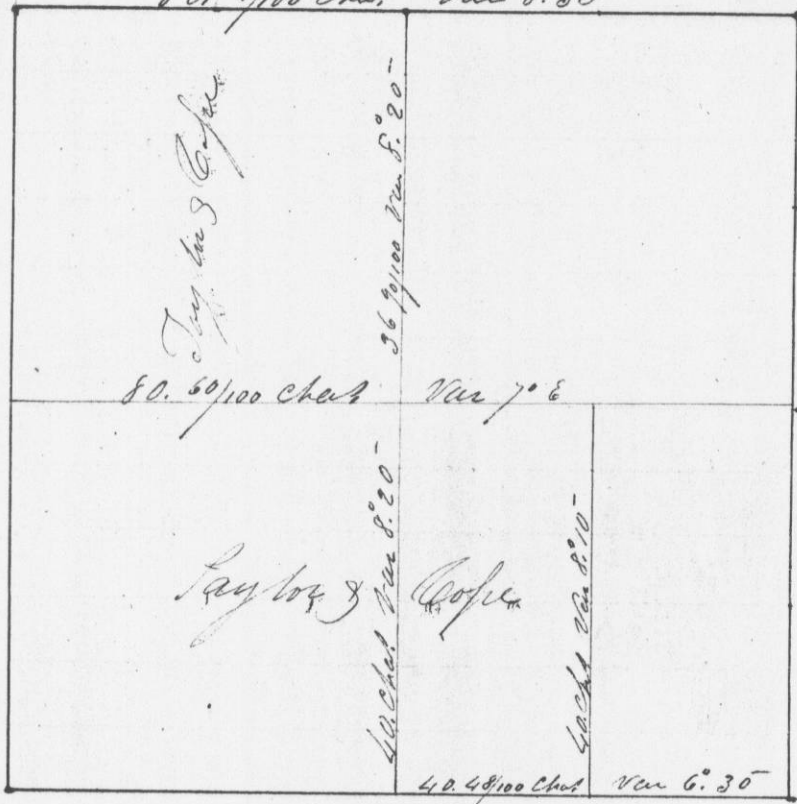

and  
The above is  
the Minutes of  
the 27th of  
Saml. C. Miller  
Capt. Dist. Surgeon  
Quart. Co. M. T.

Corners all Posts set in Moundly  
I hereby certify that the above is a true Plot  
and Copy of the Minutes of said Survey made by  
me the 1<sup>st</sup> day of May 1844 Saml. C. Miller

Dept. Dist. Surgeon  
Quart. Co. M. T.