
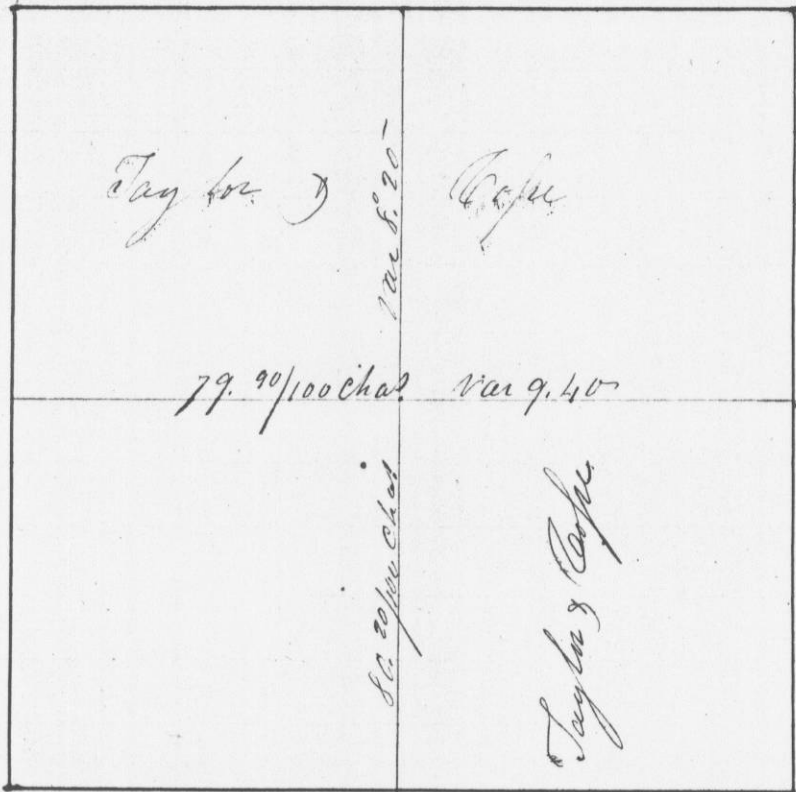


No. 336

213

Books of the
27. T 2 A R 2 W

Survey made for Herman Coffey & Thomas S. Taylor
of the E 1/2 & N W 1/4 of section 36. T 2 A R 2 W
of the 4th P. M. Mer.

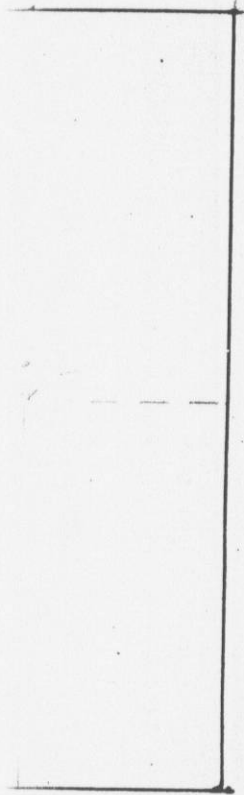

19. 262
1148 "

20 36 "

is a true Plot
and survey made
by C. Miller
Capt. Surgeon
U.S. Army

Corner marked by posts set in mounds of
Earth & rocks

I hereby certify that the above is a true Plot
and Copy of the minutes of said survey made
by me the 27th of May 1844

Saml. C. Miller
Capt. Surgeon
U.S. Army