


Survey Made for John Hopkins of the N 1/2
of the SW 1/4 of Sect. 29 T 2 N. R 1 W and for
Andrew Smither of the E 1/2 of the SW 1/4 of the
same section

4" Pr. Meri-

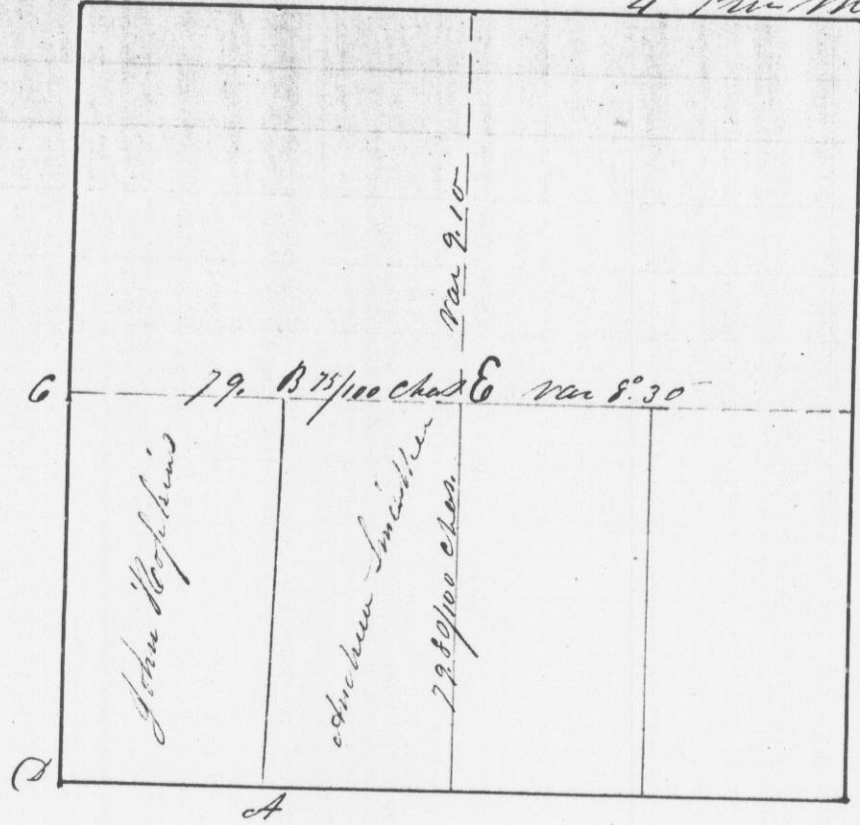

At A Post clear { Be Oak 10 S 4 E 70 Lk. 23
 At B Post in mound
 At C Post in mound

I hereby certify that the above is a true plot
 and copy of the minutes of said survey made
 by me the 11th of May 1854

Saml. C. Miller
 Capt. Dist. Surveyor
 Grant Co. N. J.

new

I hereby
 record
 by J.E.F.