
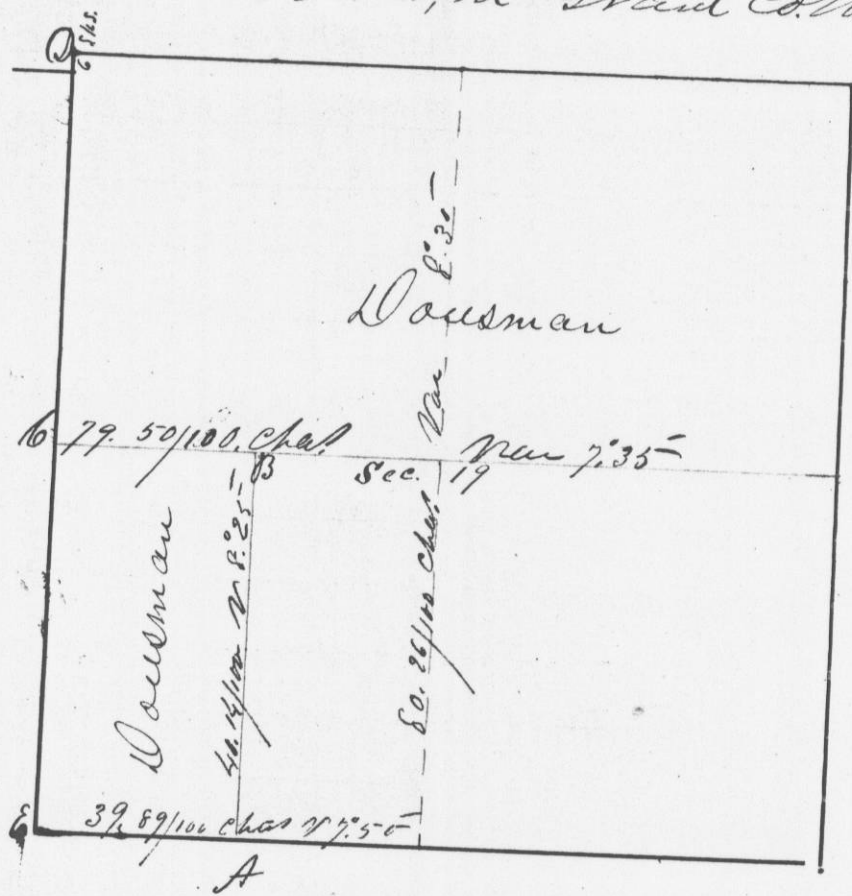


Mercurius S. Dausman

on No. 20, in  
N. of the  
W. Sec

Survey made for Mercurius S. Dausman

of the North half and N. 1/2 of S. W. 1/4 of Sec  
19, in Town 5 N. R. 2 W of the  
4th P.M., in Grant Co. W. Va.

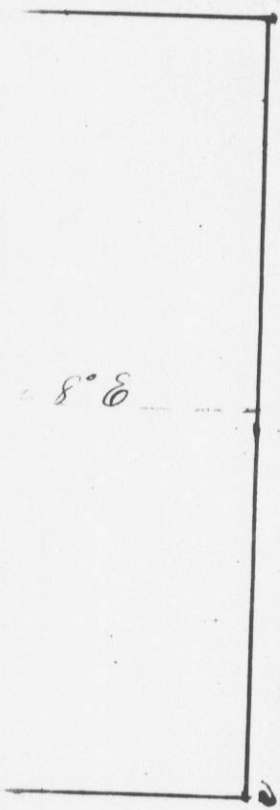

164 W 108 Sh.  
188 W 120 "  
town is a town  
of Me  
Saml. C. Miller  
Pt. Dist. Surveyor  
of Grant Co. W. Va.

At A Post Cor. } N Oak 13 at 7 1/2 E 33 Lk.  
Bearings } N " 8 S 7 1/2 W 44 "  
At B Post Cor. } N 612 S 34 W 16 "  
Bearings } " 15-133 W 66 "

I hereby certify that the above is a true  
record of said survey made by me the  
10 day of June 1846

Saml. C. Miller  
Capt. Post. Surveyor  
of Grant Co. W. Va.