


234

No. 347.

Survey of the S.E. 1/4 and E 1/2 of N.E. 1/4
of Sec. 24, Town 5 Range 3 N. of the 4th P.M. 2c. 7c.
for H. L. Dausman

Survey

W 1/2 of

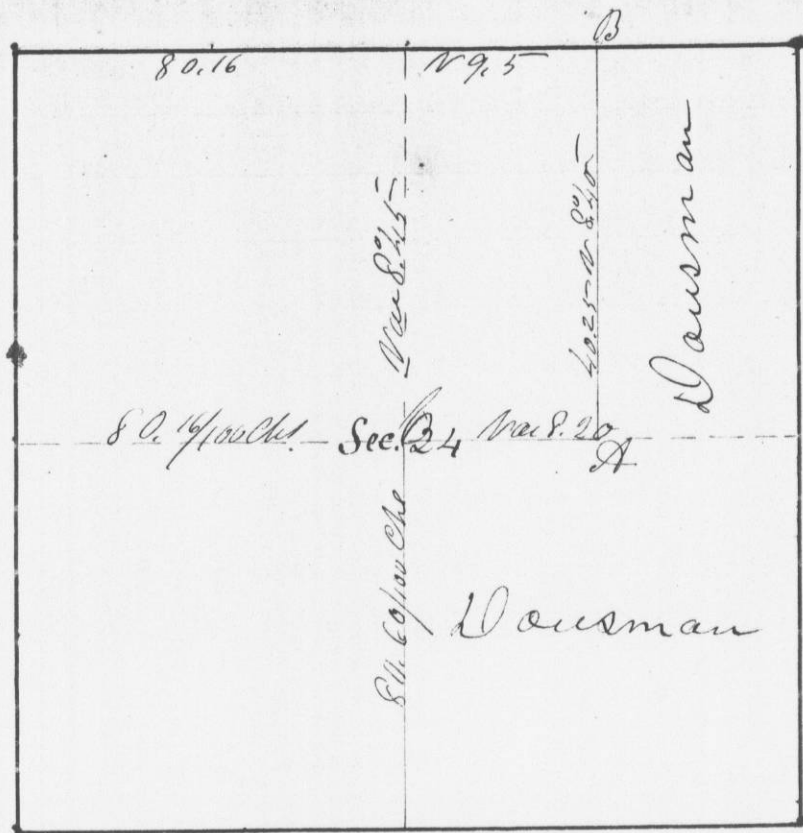

at A Post Co. { Jack Oak 12 S 87 W 125
 { be oak 10 S 27 W 80
 at B Post Co. { bl O 20 S 2 W 31
 { M O 12 N 68 E 21
 at C Post Co. { M O 12 S 42 E 24
 { " 8 S 56 W 21

at A Post Co.
Bearings
at B Post Co.

at C Post Co.

I hereby certify that the above is a true record of said survey made by me the 5 day of June 1847.

I have
record
18 day

Saml. C. Miller
Capt. Dist Surveyor
Grant Co. W.V.