


Dousman

Survey made for Hercules L. Dousman of the

W. 1/4, in Town
No. 1, in S.E., 4th R.

E. 1/2 of N. W. 1/4 of Sec. 1, in Town 4 N. in Range 3
West of the 4th P.M. in S.P., 4th S.

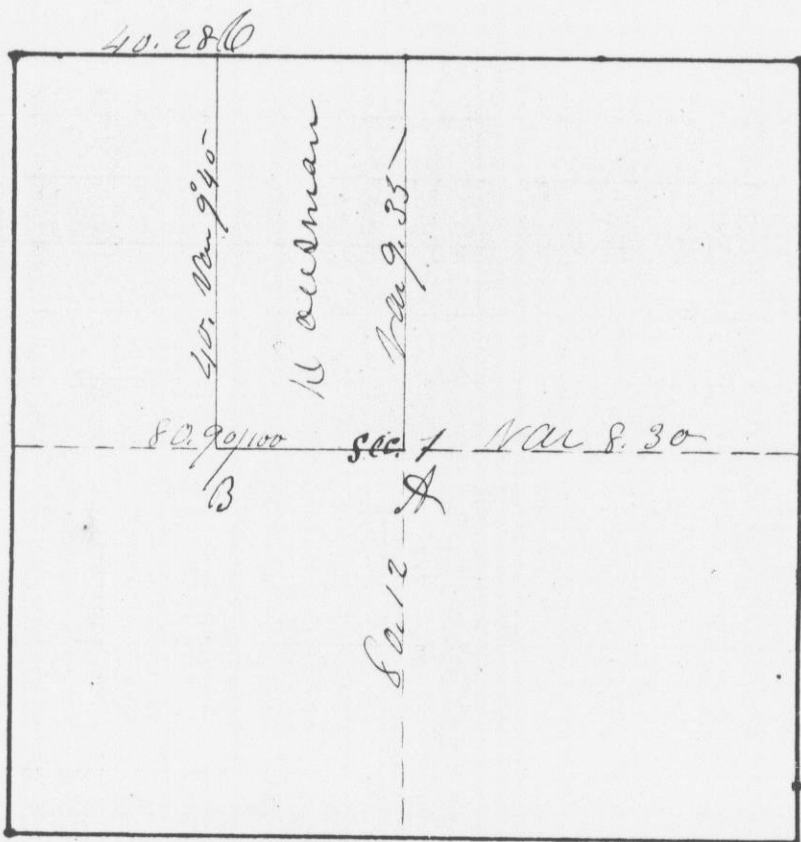

at A Post Cor of A in 1/4 S 77 1/2 E 5 2 1/4
 Bearing No 6 4 N 77 W 25
 at B Post Cor of Jack 06 N 24 E 89 1/2 S 10
 No 7 S 87 W 214 "
 at C Post Cor of No 12 A 4 W 105 "
 Jack 08 S 76 W 12 " 10

I hereby certify that the above is a true
 record of said survey made by me the 1st
 day of June 1844

Saml. C. Miller
 Dep't Dist Survey
 of Grant Co W. S.

21 S. 1.
 22
 25-
 18
 23
 is a true
 as by me
 1844
 S. C. Miller
 Dist. Surveyor
 of Co. W. S.