


238

No. 351.

Survey made for H. S. Dawson of the E 1/2 of S.E. 1/4 of Sec 26 in Town 5 N. Range 3 West of the 4th P.M. in Grant Co. W.T.

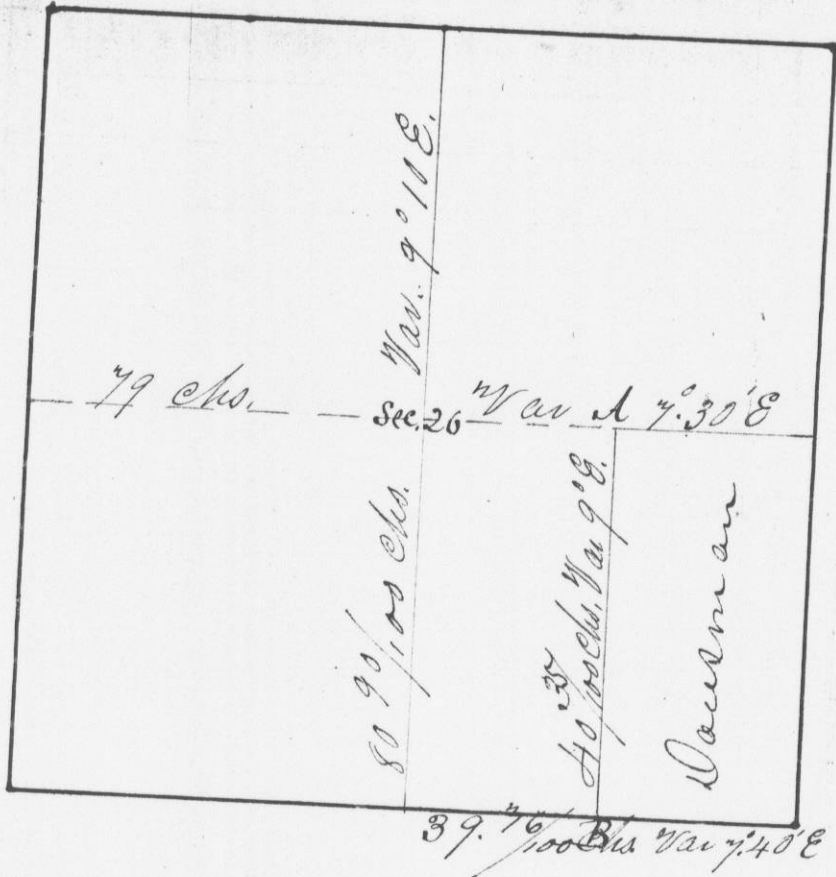

Bearings N.O. 12 N 19 W 23 Bear N.O. 9 N 40 E 45  
 at A " 10 S. 55 1/2 E 39 at B " 11 S. 70 W 33

I hereby certify that the above is a true and correct copy of said survey, made May 31st day of May, 1844 H. A. Wilts  
 Dist. Sec. of G. W. T.

at A Point  
 Bearing  
 at B Point

at C Point

recor  
 day