


242


No 354.

Survey made for Jas. H. Bull of Lot No 2 in Survey made
fract. Sec. 15. in Town 2 N. in R 3 W. of 4th P.M. S.E. 1/4 and
in Grant Co Wis. Town 5 N. of 11

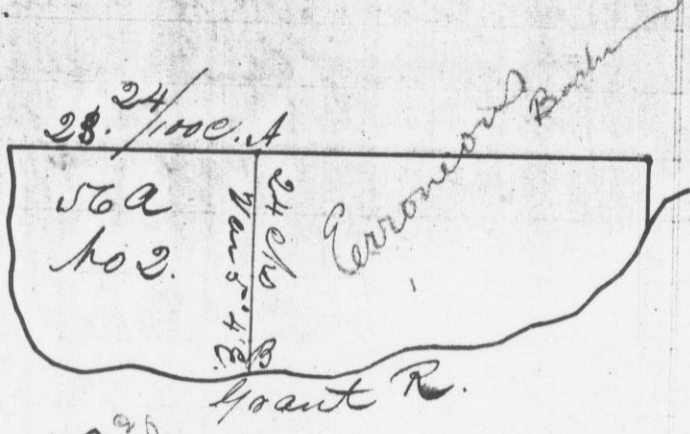

Bearings N. 18th 47th W 30th Been Cottonwood 11 S. 85th W. 15th
at A. do 19 S. 55th E 14th at B M. Rich 14 N 88th E. 48

I hereby certify that the above is a
true record of said Survey, made by me
Jan 28th 1844
H. A. Wittes
Dist Sur of G.C., Wis.

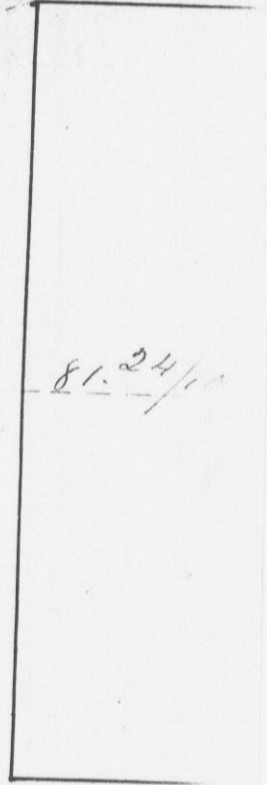

81. 24/100

See B.O. 11 S. 140th
+ b } Bro. 6 St. 8

See M.O. 16 S. 15th
+ d } Estab. d

See Bro. 14 S
+ f } do 14 " "

a true record
made on the