

240


~~170359~~

2247
247

Brooks of
Wign and the



Surveyed for Silas Brooks the West 1/2 of the
N.W. qr. of Section No. 35 of Township No. 2 of
Range No. 2
West of the
4th principal
-al Meridian

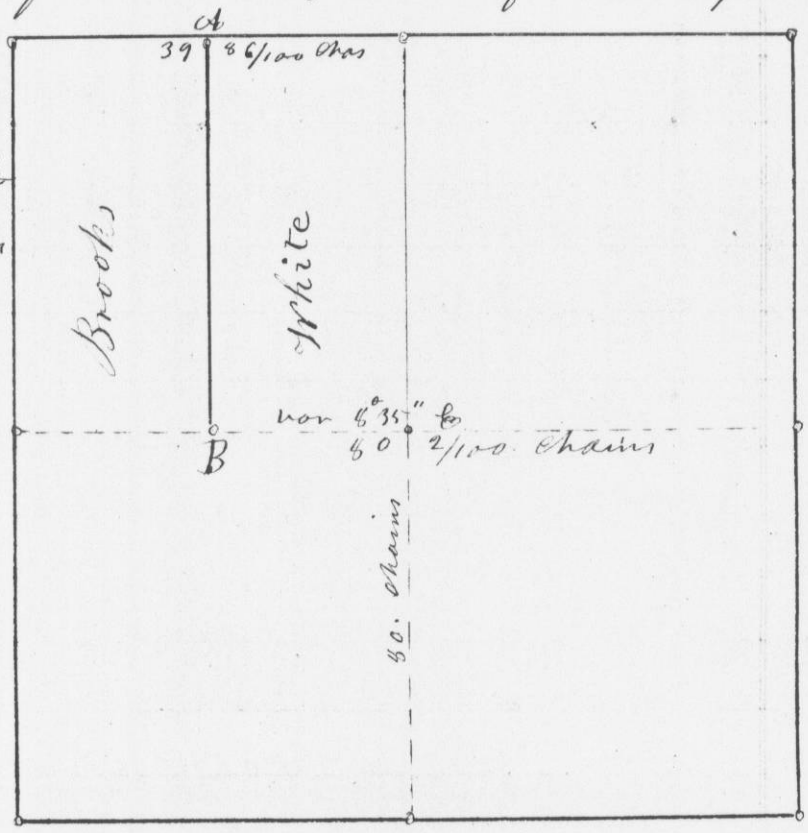

10 B. oak 16 N. 75 1/2 W. 90 1/2 links
Bearings at A Do " 12 S. 46 W. 166 links
... at B part in mound

I hereby certify the above to be a true
copy of survey made by me this 15th
day of Sept. 1844
Jon C. Freeman
Dept. Dist. Surveyor
G. C. W. D.

1/2 links }
" " }
157
19
11
37

is a true copy
this 14th day
Freeman
1. Dist. Sur
G. C. W. D.