


Survey for Joseph Woolley of the N.W. 1/4 of S.E. 1/4 of Section 23 in Town 3 of Range 3 west of the 4th Principal Meridian in Grant County W.T.

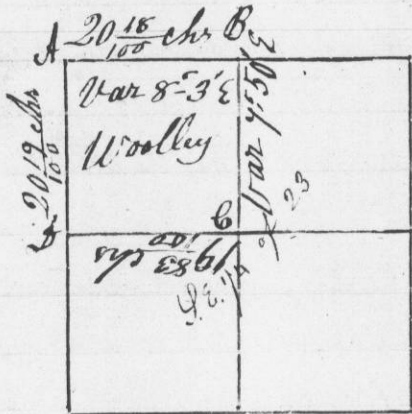

A. Post in Mound } 9

Bearings yellow oak 6 East 15 } Bearings Br. o. 4 N 86 1/2 W 55
at B " " 8 S 36 E 25 } at C " y. o. 2 N 37 W 30

at D Post in Mound

I hereby certify that the above is a true and correct Record of said survey made Dec. 19th 1844

Stephen Mahood Dep
Dist. Surveyor G. C. W. T.

Survey made for Benjamin G. Wright, Phineas Wright and Samuel Wright on Sec 35 in Town 3 of Range 3 west of the 4th Principal Meridian in Grant County W.T.

Commencing at a stake on line between sections 34 & 35 and 13 chains from Town line; from said stake

S 64 1/2 E 2 7/8 chs to double white oak stump

S 66 3/4 E 5 1/8 chs to " " stump

S 74 1/4 E 4 6/100 "

S 82 1/2 E 2 6/100 "

N 63 E 1 7/100 "

N 57 1/2 E 10 5/100 " W. O. 12 S 57 1/2 W 6 Sinks

S 77 3/4 E 5 1/100 "

N 36 E 18 "

N 68 W 9 "

N 83 W 9 "

S 87 W 12 8/100 "

S 1 1/2 E 9 4/100 "

S 87 1/2 W 5 "

South 14 " to beginning

I hereby certify that the above is a true and correct Record of said Survey made Dec. 19th 1844

Stephen Mahood Dep
Dist Surveyor G. C. W. T.