


Survey made for Mrs N. Reed of the E. 1/2 of S.E. 1/4 of Sec 24 in Town 4 of Range 5 west of the 4th Principal Meridian in Grant County W. T.

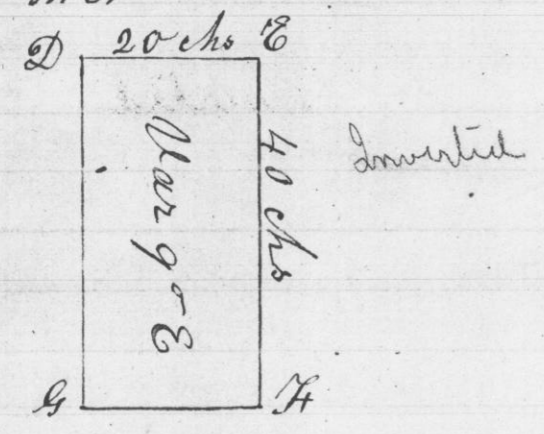


Original { M. O. 32 S 56 1/2 W 37 } Bearings at D
B. O. 6 N 2 1/2 W 350 } (see survey N^o 366)
20 } Post in mound at E
17 } Post in mound at H in Field

Original { M. O. 18 S 1/2 W 4.81 } Bearings at G
B. O. 16 S 87 1/2 W 7.70 }

Commencing at sec corner bet 24 & 25 at D
West 20 chains to Post in mound at E
North 40 chains to Post in mound at H
in a Field
East 20 chains to 1/4 Post on Town line at G
South 40 chains to beginning

I hereby certify that the above is a true and correct Record of Survey made Dec 31st 1844
Stephen Mahood Dep
Dist Surveyor G. C. W. T.

Survey made for Mrs N. Reed of the E. 1/2 of N.E. 1/4 of Sec 25 in Town 5 of Range 5 west of the 4th Principal Meridian in Grant County W. T.

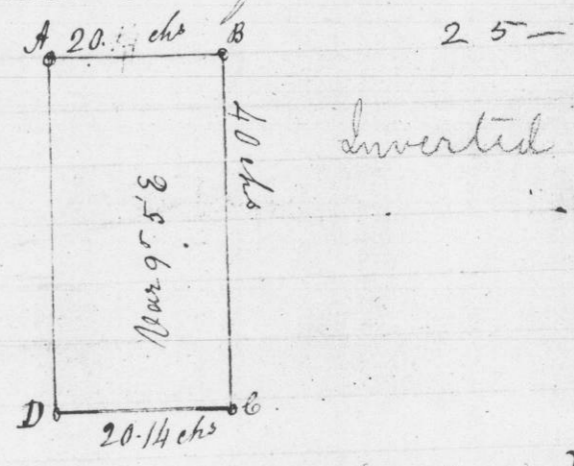

Original { Elm 12 S 3 1/2 W 17.86 } corner of Secs 24 & 25
Bearings at D { B. O. 7 N 37 W 316 }
" at C { M. O. 9 N 13 E 272 }
" " 12 N 52 E 388 }
" at B { B. O. 10 S 70 E 31 }
" " 10 N 37 W 55 }
" at A { Aspen 10 S 21 W 22 }
Original { Lynn 15 N 27 W 83 }

Commencing at corner of Secs. 24 & 25 at D
West 20 1/4 chains to 1/8 Post on sec line at C
South 40 chains to 1/8 Post at B
East 20 chains to 1/4 Post on Town line at A
North 40 chains to beginning

I hereby certify that the above is a true and correct Record of Survey made Jan 1st 1845
Stephen Mahood Dep
Dist Surveyor G. C. W. T.