


Survey made for John Heathcock of
 the North East quarter of Section the North
 East quarter of Section No 36 in Town No
 6 North of Range No 2 West of the 4th
 principal meridian in Grant County W. Va
 February 4th 1846

N.E. 1/4 of Section No 36 in Town No 6 N. of R. No 2 West

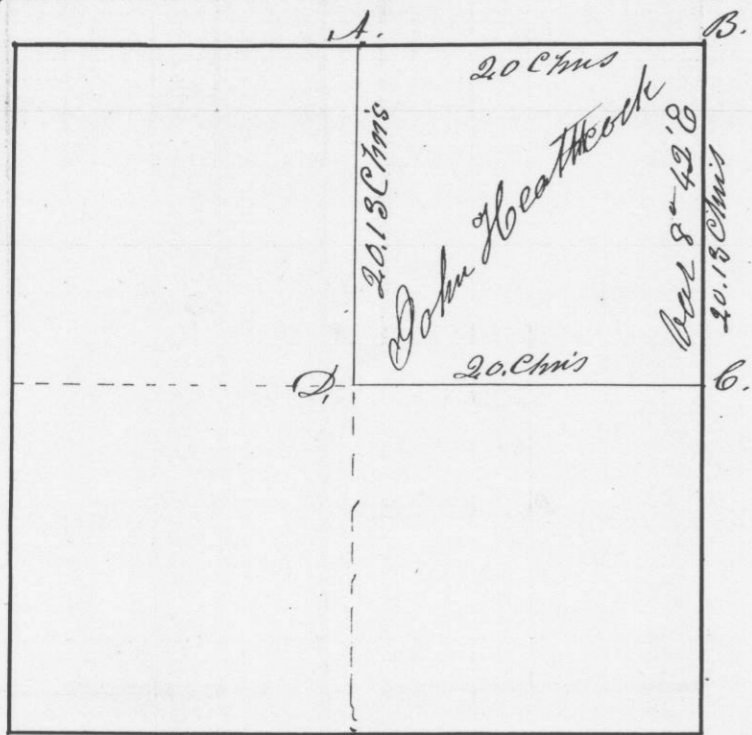


Corners

- at A. { Br. Oak 15 S 70 1/2° E 47 links } 15
 { Br. Oak 5 N 44° E 48 links }
- at B { Br. Oak 24 S 19° W 453 links } original
 { Br. Oak 20 N 71 1/2° W 1000 links }
- at C Br. Oak 15 S 81° W 438 links 16
- at D W. Oak 10 N 63° W 202 links
 W. Oak 18 N 81 1/4° W 199 links

I hereby certify that the above is a true
 plot and correct minutes of said survey
 made by me this 4th day of February 1846
 A true record. Attest Geo. N. Stantzy

Survey made for John Heathcock of the E 1/2 of the N.E.
 1/4 of Section No 29 in Town No 6 North of Range No
 1 West of the 4th principal meridian in Grant County
 W. Va February 5th 1846

Section No 29 Town No 6 North of R. 1 West

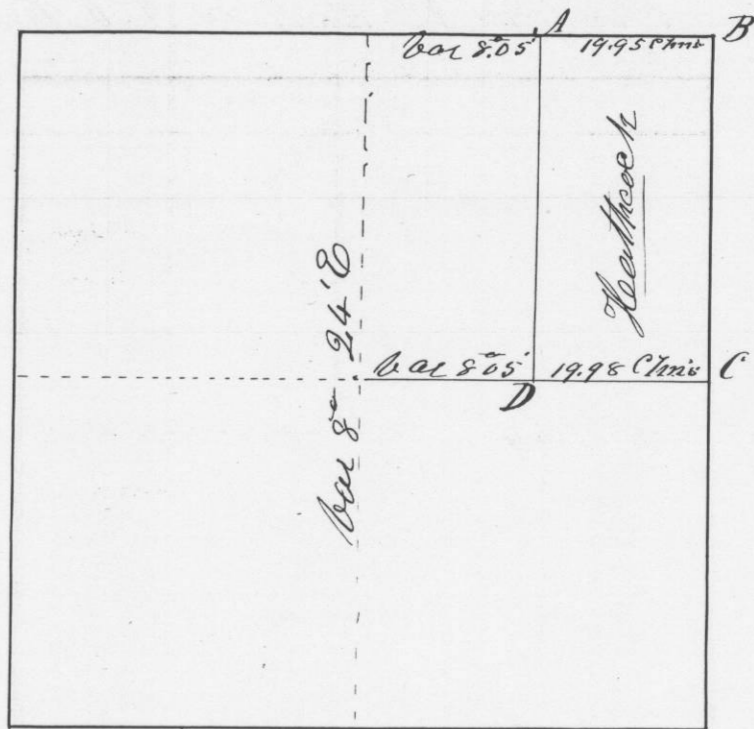

Corners

- at A & D. Set posts marked 1/85
- at B & C Set posts in the original mound

I hereby certify that the above is a
 true plot and correct minutes of said
 survey made by me this fifth day of
 February A.D. 1846

A true record. Attest Geo. N. Stantzy
 District Surveyor
 G. C. W. J.