


Survey made for Daniel H. Budd of
 the East half of the south West quarter
 of section No 34 in Town No 5 North of Range
 No 3 West of the 4th Meridian Grant County N.S.
 March 22nd 1847

Section 34 T. 5. R. 3. West

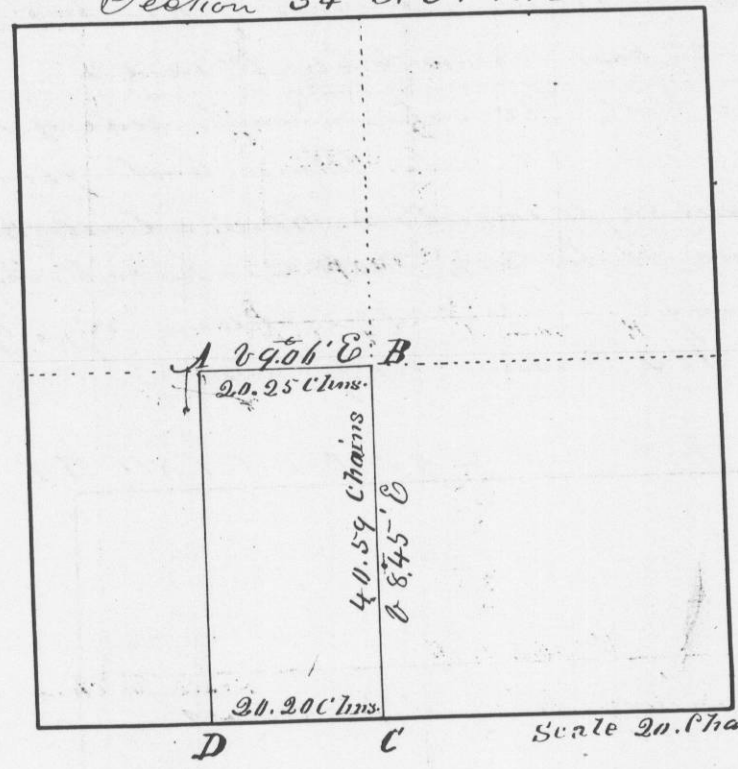


- Bearings taken at the corners
- Distances at A { White Oak 10 S 19° W 100 links } courses
 correct { White Oak 12 S 65° E 126 links } right
- " B { White Oak 14 N 54° E 63 links }
 { White Oak 10 S 71 1/2° W 232 links }
- " C Original corner
- " D { Br Oak 10 S 13 1/2° E 54 links }
 { Br Oak 6 N 10° E 228 links }

I hereby certify that the above is a true record
 of the plot and minutes of said survey
 made by me March 22nd 1847
 Geo. R. Stuntz
 Dist. Surveyor

Survey made for James Campbell of the South
 west quarter of the North East quarter and the
 east half of the South West quarter of section No 26
 in Town No 4 North of Range No 1 West of the
 4th Meridian.

Section 26 T. 4. R. 1 West

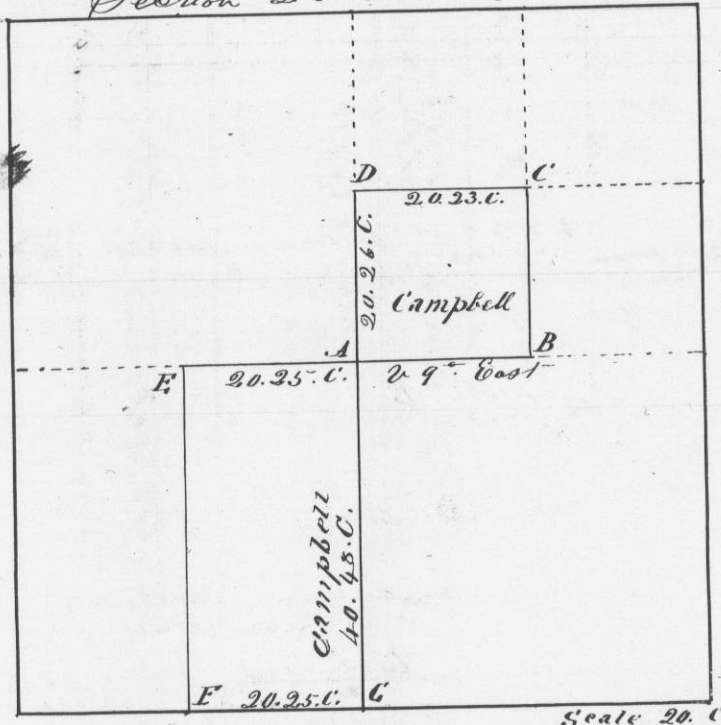

Bearings taken at the corners

- | | |
|---|--|
| 11 A { White Oak 15 N 22 1/2° E 130 links }
{ White Oak 15 S 78 1/2° E 103 links } | at E { White Oak 12 S 17° W 18 links }
{ White Oak 13 S 57 1/2° W 136 links } |
| 17 B { Black Oak 8 N 1 1/2° W 33 links }
{ White Oak 7 S 77 1/2° W 75 links } | " 23 { White Oak 12 N 7 1/4° E 67 links }
{ Black Oak 12 N 34 1/2° W 72 links } |
| 18 C { White Oak 12 S 82° E 28 links }
{ Ironwood 8 S 46° W 81 links } | " G. Original bearings |
| 11 D { White Oak 18 S 9° E 44 links }
{ Black Oak 18 N 72 1/2° E 85 links } | |

I hereby certify that the above is a true plot
 and correct minutes of said survey made by me
 this 24th day of March 1847

Geo. R. Stuntz
 Dist. Surveyor G. Co. N.S.