


Survey made for Arch Sampson of the West
 half of the N.W. quarter of Section No. 25 in Township
 No. 1 North of Range No. 2 West of the 4th Meridian
 June 16th 1847
 Corners established by running as the law directs

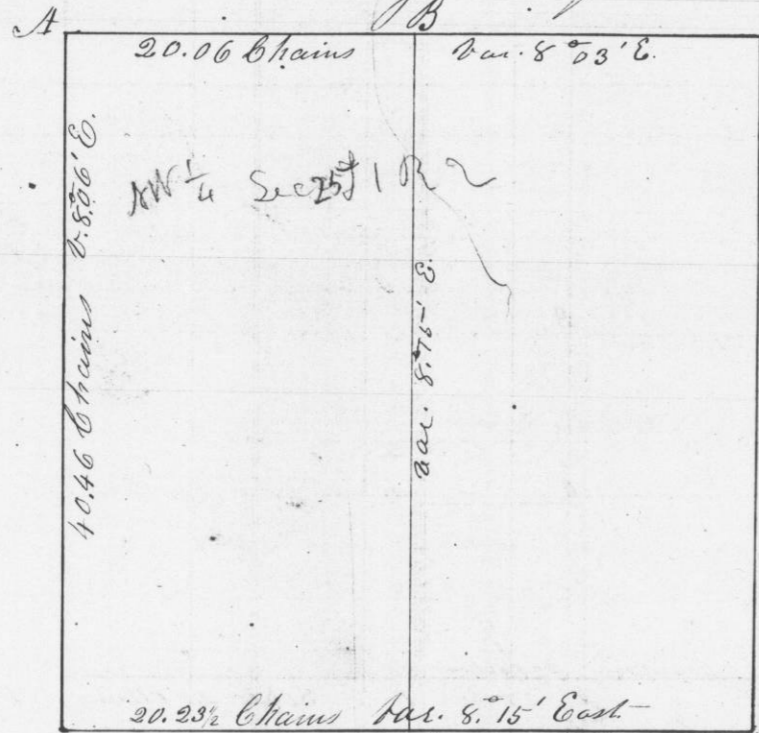


- Scale 10 chains to the inch
- 1 at A Red Cedar post 3 inches square
 - 10 at B Stone Monument 6 inches square 20 in. long
 - 12 at C Stone Monument 6 inches square { B.C. 10. N 12 1/2 W 97
 - 8 at D Red Cedar post 6 inches square { B.C. 12. N 40 E. 140 line
 - 10 Bearing at B { White Oak 10 S 66 1/2 E 173 line

I hereby certify that the above is a true plot
 and correct minutes of said survey made
 by me the 16th day of June A.D. 1847

Geo. R. Clunty
 District Surveyor of
 Grant Co.
 W. Va.

1933
 1934
 1935
Survey made for Hugh Calhoun and John McCullough
 in the S. 1/2 of the E. 1/4 of Section No. 18 in Township No. 2 North
 of Range No. 1 West of the 4th Principal Meridian
 Commencing at the S.E. corner of said section. Thence West variation
 2° 40' E. 19.91 chains and set post. Thence North var. 8° 36' E. 19.93 chains
 and set post. Thence North 19.93 chains to N.W. corner of said S. 1/2
 Thence East 20 chains to 1/4 section corner. Thence South var. 8° 36' E. 19.93
 chains to post. Thence south to the place of beginning 19.93 chains
 Thence returned to last mentioned and blazed a line due West
 through the center of said tract of land. also marked new
 bearing trees at the corners of secs. 17, 18, 19 & 20 White Oak 16 N. 5° 56' 48" E
 The original trees having been destroyed White Oak 7 N. 56' 2" E. 120 Ch.

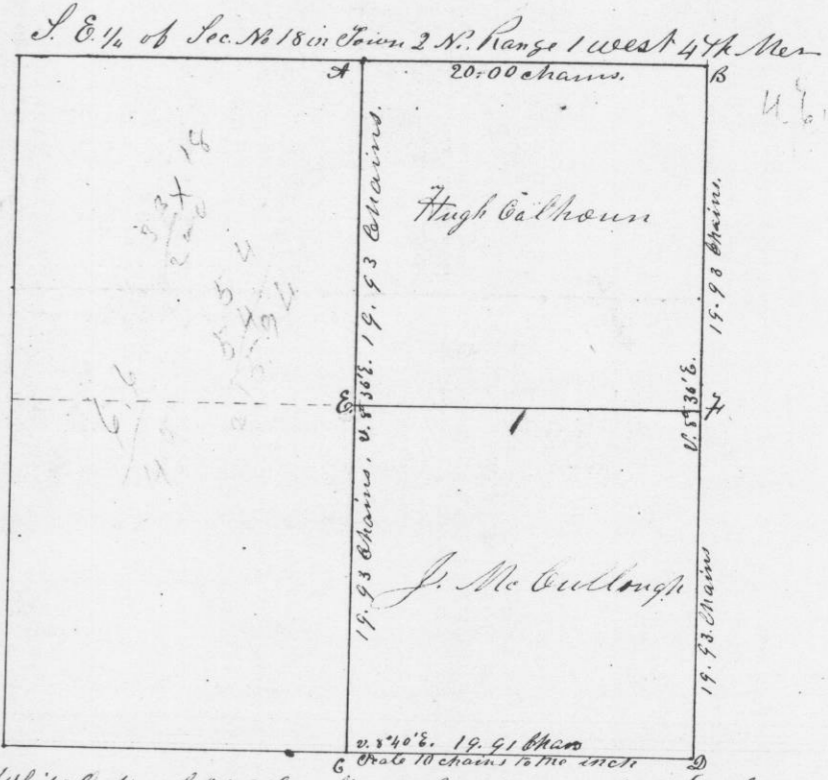

Bearing at C. White Oak S 54° W. 10 links. Bearings at F White Oak 8 N 45° E 216
 Black Oak 10 S 27° E 246

I certify that the above is a true plot and correct minutes
 of said survey made by me this 26th day of June A.D. 1847.
 Geo. R. Clunty