



Survey made for Thomas Webster of the E 1/2
 of the N.W. 1/4 of Section No 28 in Township No 4
 North of Range No 5 West of the 4th Principal Meridian
 Sec 28-54-R 5 W- March 10th 1848

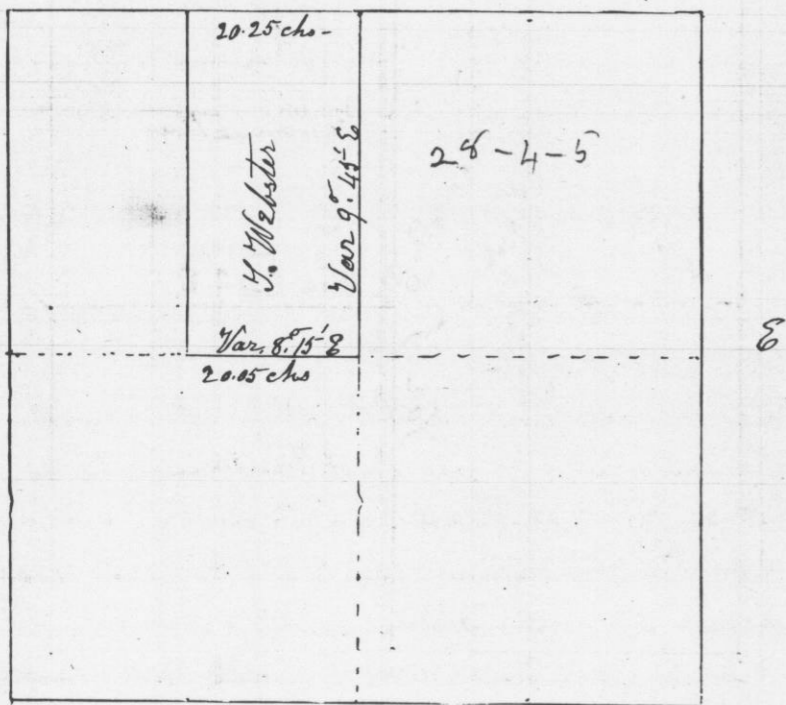

Commencing at 1/4 Post on North side. Thence ^{west} 40.50 links
 Var 8.5 E, intersected section line 35 links North of section
 corner - Thence from 1/4 Post on west side of section
 East Var 8.30 E, ^{40.10 links} intersected 36 links North of 1/4 Post
 on East side - Thence from 1/4 Post on South side of
 section North, Var 9.45 E intersected at 1/4 Post on North
 side of section - corrected to center set Post
 Bearings - B. O. 6 N 30 1/2 W 220 links - no bearings given for
 S.W. & N.W. corners -

I hereby certify that the above is a true Plot and
 record of the minutes of Survey
 Geo. R. Shantz
 District Surveyor
 G. C. Wis-

Survey made for G. B. Jones of a lot of land in
 the N.W. 1/4 of the S.E. 1/4 of Section No 26-53-R 3 west of the
 4th Principal Meridian
 N.W. 1/4 of S.E. 1/4 of Sec 26 53-R 3 W

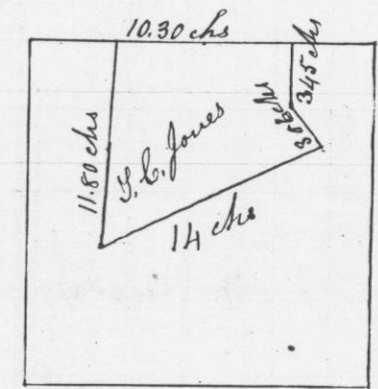

Var 8.45 E
 Scale 10 chs to the inch

Commencing 5 chains East of N.W. corner of N.W. 1/4 of S.E. 1/4 of Sec 26-53-R 3
 Var 8.45 E - Thence S 2 1/2 W 11.80 chains to the centre of a W. O. Stump
 12 inches Diameter - Thence N 65 1/4 E 14 chains, Br. O. 4, N 82 W 30 links
 Thence N 37 W 306 chains - set Post - Thence North 345 chains
 to the N. side of said 40 - Thence West to the place of beginning
 N.E. corner W. O. 20 N 20 1/2 E 23 links - -

I hereby certify that the above is a true Plot and record
 of survey made March 21st 1848
 Geo. R. Shantz
 District Surveyor
 G. C. Wis-