


Survey made for Ben. C. Eastman & F. J. Dunn of the E_{1/2} of the N.E_{1/4} of Section No 25 in Township No 6 N. & Range No 1 west of the 4th Principal Meridian commencing at the 1/4 Post on the North side of section Thence East Var 8° 40' E; intersected Corner 40 links North Thence South on Meridian. intersected 60 links East of 1/4 Post Var 8° 30' E. South through Centre of section. intersected 35 links west - Thence West through centre; Var 8° 30' E intersected at 1/4 Post - E_{1/2} 40.04 chains.

Sec 25 - T6 - R1

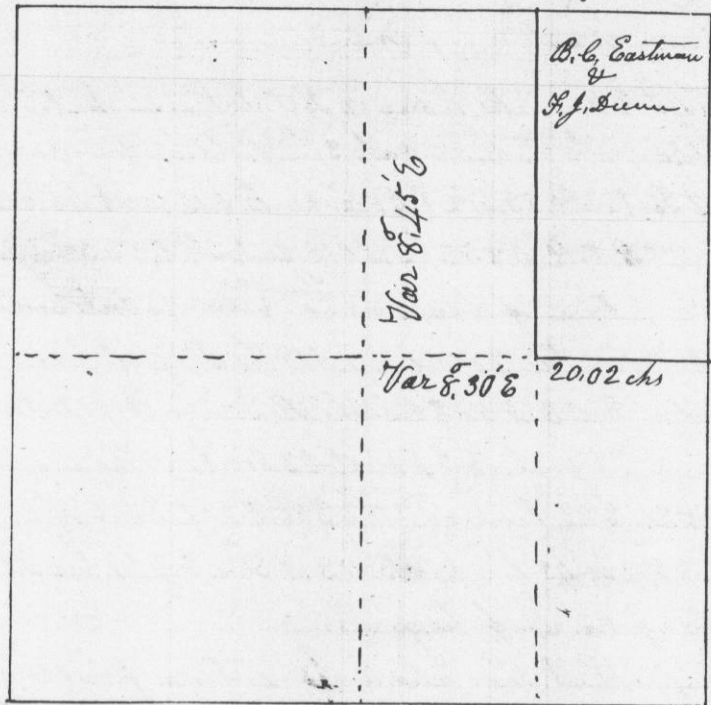

I hereby certify that the above is a true plot & record of Survey made April 4th 1848.

Geo. R. Steuby
District Surveyor
G. C. Wis

Survey made by the order of the Commissioners appointed to Survey and adjust the Claims to lands in Bectown in Section No 30. in Township No 4 North and Range No 4 west of the 4th Principal Meridian April 18th 1848. Commencing at the N.E. corner of section - Thence West. Var 8° 30' E - 40.14 links intersected 9 links South of 1/4 Post. Thence East from 1/4 Post on west side of section Var 8° 30' E. intersected 67 links North of 1/4 Post on E. side of section; Established New bearings = White oak 16 N. 62 1/2 E 93 links White oak 5 N 54 W 51 links - Thence South on East side of section Var 11 E; 40.50 chains intersected 7 links East of corner. Thence west from corner Var 8° E; 40.09 links - intersected 60 links North of 1/4 post - Thence North through Centre of section Var 11 E; South half being 40 chains; North half 40.30 chains - intersected 30 links East of 1/4 post - Corrected back to centre & set 1/4 Post - bearings W. O. 15 S 64 W 9 links = W. O. 18 N 50 E 66 links - Thence East 40.17 links Corrected back 20.8 1/2 links - Set 1/8 Post. Ironwood 7 S 27 1/2 W 77 links Ash 6 N 33 1/2 E 1.71 links - Thence South from N.E. corner of section Var 11° 05' E; 40.00 links intersected at Post = Thence South through the centre of the S.E. 1/4 of section Var 11° 10' E; intersected 24 links East of 1/8 Post = Thence West through S.E. 1/4 from 1/16 Post on East side - intersected 16 links North of Post = Corrected back to centre of said quarter 19.94 chains; Set post B. O. 5 North 75 links - W. O. 5 S 45 W 62 links .. S.E. corner - Stone Monument = Iron 1/4 Post in centre of section; Thence west 37.86 links - Thence South Var 10° 30' E; 39.90 links - intersected 42 links East of corner Thence East. Var 8° 30' E; 38.45 links; intersected at Post; took bearings (No 4) B. O. 8 N 34 W 159 links = B. O. 9 N 25 E 1.39 links (No 3) W. O. 5 S 68 E 1.24 links = W. O. 5 S 45 E 23 links = (No 6) B. O. 10 S 19 E 50 links = W. O. 18 N 33 W 31 links (No 9) B. O. 12 S 53 1/2 W 70 links - B. O. 15 N 50 E 63 links (No 10) B. O. 8 S 35 E 23 1/2 links; B. O. 6 N 48 1/2 E 41 links

For Plot 46, see next Page after No

S.E. Corner of Sec. 30 T. 4 R. 4 W } B. O. 13 S 61 E 61
Taken 1868 } W. O. 10 S 60 W. 29
Barber