


Survey made for Martin Heurich of the N.W. 1/4 of the S.E. 1/4 of Section No 19 in Town No 4 North of Range No 3 west of the 4th Principal Meridian August 10th 1848

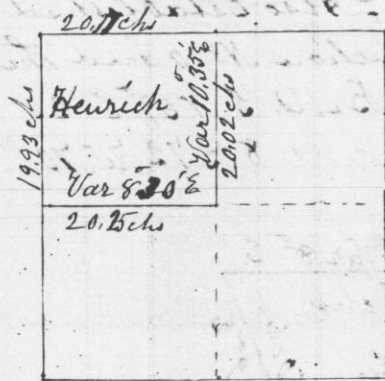


Commencing at 1/8 Post West of centre set by H. A. Wittes Var 7.30 E - Thence East 60.34 chains to 1/4 Post between sections 19 & 20 intersected 114 links South of Post Thence var 8.30 E - Corrected back to 1/8 Post East of Centre - Set Post bearings Sugar 12 N. 34 W 61 links }
" 10 N 75 W 60 " }
Thence marked back to centre line through Centre of section 19 & marked by H. A. Wittes see Survey No 278 - Bearings at Centre Sugar 8 57 1/2 W 7 links }
" 9 N 84 1/2 E 21 " }
Thence South to 1/4 Post between sections 19 & 20 - 39.8 chs }
corrected back & set 1/16 Post = Sugar 16 N 28 W 24 links }
" 13 S 23 W 56 " }
Thence East from 1/4 Post on South side of section 19 40.12 chs Var 8 E intersected 8 links South of corner - Corrected back to 1/8 Post Thence North 40.04 chains - Var 10.35 E intersected at 1/8 Post - Thence corrected back set 1/16 Post bearings Sugar 12 N 78 W 43 links - R. O. 10 S 14 E 44 links = Thence West 20.25 chains to 1/16 Post

I hereby certify that the above is a true & correct record of survey
Geo. R. Stuntz
District Surveyor
G. C. Wis -
Per Stephen Mahood

Survey made for Matthias Hann of the N.W. 1/4 of the S.W. 1/4 of Section No 19 - 24 - 23 west of the 4th Principal Meridian August 10th 1848

Commencing at 1/16 Post on the line between the Centre of section and the 1/4 Post on the South side of section - Thence South 9.96 1/2 links; set 1/32 Post - bearings Sugar 52 52 1/2 W 24 links
Sugar = 52 5 1/2 E 58 links
Thence East 20.07 chains to 1/32 Post on corrected line set post bearings Elm 11 N 11 E 55 links - Sugar 15 S 4 W 39 links }
Thence North to 1/16 Post; Sugar 12 N 78 W 43 links - R. O. 10 S 14 E 44 links }
Thence West 20.25 links to the place of beginning

S.E. 1/4 of Sec 19 - 24 - 23 -

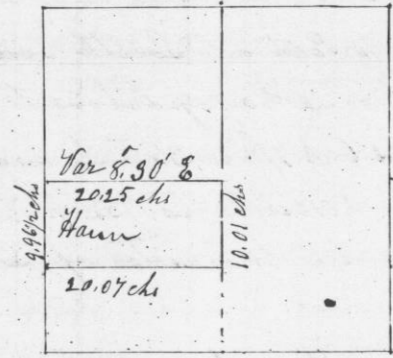

I hereby certify that the above & foregoing plot and minutes of survey are correct

Geo. R. Stuntz
District Surveyor
G. C. Wis
per Stephen Mahood
Deputy