


Survey made for Jacob Stittgen of the S¹/₂ of the S.W¹/₄ of the S.E¹/₄ of Section No 19 in Township N^o 4 North of Range N^o 3 west of the 4th Principal Meridian August 10th 1848

S.E¹/₄ of Sec 19-T4-R3

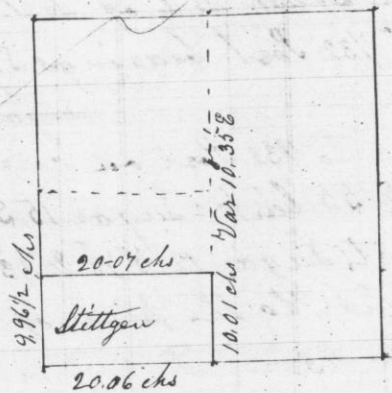


Commencing at the 1/4 Post on South side of section
Thence East 20.06 chains to 1/8 post-set post on corrected
line, Bearings-Ironwood 6 N 7 1/2 W 35 links Sugar 11 East of ^{side} the
corner - Thence North 10.01 links to 1/32 post - see bearings
to this & other corners in minutes of survey under
No. 550 -

I hereby Certify that the above & foregoing is a true
and correct Record of Survey

Geo. R. Stuntz
District Surveyor
G. C. Wis
Jr. Stephen Mahood
Deputy

Survey made for John Ery, of the N.E¹/₄ of the N.W¹/₄ of Section No 30 in Township N^o 4 North, of Range N^o 3 West of the 4th Principal Meridian, August 11th 1848
N.W¹/₄ of Sec 30-T4-R3

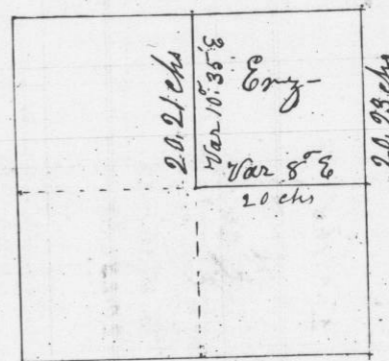

Commencing at the 1/4 Section Post on the North side of section
Thence South to 1/4 Post in centre of Section 40.42 chains
Var 10 35 E intersected at Post - Corrected back to 1/16 Post
set Post; bearings - W. 0.14 S 59 E 30 links - W. 0.20 N 40 W 57 links -
Thence South from 1/8 Post set by H. A. Wittse on North side of N.W¹/₄ of
section (bearings - S. 12 55 1/2 E 102 links - W. 0.32 N 45 W 184 links)
(see Book A. No 311) 40.46 chains to 1/8 Post set by J. Freeman
Corrected back 20.23 chains set 1/16 Post - bearings, Elm 26 57 1/2 W 5 links
Ironwood 6 N 83 1/2 E 24 links; Thence East 20 chains to 1/16 Post -

I hereby certify that the above is a true & correct representation
of survey made Aug¹¹ 1848

Geo. R. Stuntz
District Surveyor
G. C. Wis
Jr. Stephen Mahood
Deputy