


Survey made for Christian Olinger of the N¹/₄ of the S¹/₄ of the S¹/₄ of section No 36-33-R-3 west of the 4th Principal Meridian - Sept 19th 1848
 commencing at 1/16 post set by J. E. Freeman on the section line between the S¹/₄ of sec-35 & the S¹/₄ of sec-36-33-R-3 - bearings - W. 0.26528 W 47 links W. 0.12 N 45 1/2 E 109 links - Thence East 10 chains - Elm 16589 W 44 links - Thence South 10 chains - W. 0.20 East side of the corner - Thence West 10 chains to section line. W. 0. Stump 12572 W 7 links
 " " " 15 N 58 1/2 E 36 " Thence North 10 chains to the place of beginning
 S¹/₄ of S¹/₄ of sec 36-33-R-3 -

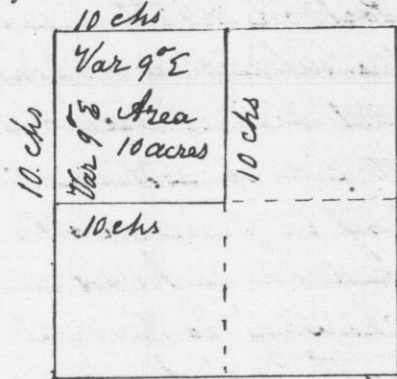


Scale 10 chains to the inch

I hereby certify that the above is a true plot and correct record of survey

Geo. B. Sturtey
District Surveyor

G. C. Wis
Pr Stephen Mahood
Deputy

Survey made for John Edwards of the S¹/₄ of the N¹/₄ of section No 25 in Township No 1 of Range No 1 west of the 4th Principal Meridian, June 12th 1848
 N¹/₄ of sec-25-31-R-1 West

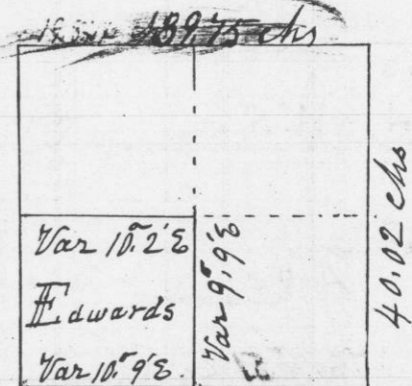

19.91 chs

Commencing at 1/4 post on North side of section - Thence East 39-75 chains - Var, 9° E - intersected 68 links South of corner - Thence South 40.02 chains - Var 9° E intersected 7 links East of 1/4 post - Thence West 39.82 ch - Var 10° 9' E, intersected at Centre post - corrected back 19.91 chains, and set 1/8 post - red Cedar, from which the N.S.W. corner of Hiram Wetherbee's House bears N. 27 1/2 E 113 ch - Thence North through the Centre of the N¹/₄ of section - Var 9° 9' E - Thence East from 1/16 post North of centre of section, through the Centre of N¹/₄ - Var 10° 5' E; intersected 5 1/2 links North of 1/16 post - on East side of N¹/₄ of section - corrected back to centre of N¹/₄; set 1/16 post - red Cedar 3 inches square - marked 1/16 S; bearings
 B. O. 7. 5. 80 1/2 W 44 links = B. O. 5 N 57 E 121 links - bearings at N.W. corner of S¹/₄ of N¹/₄ of section (set by H. A. Wiltse in mound) = B. O. 8. 5. 24 W 83 links -
 B. O. 7 5 1/2 E 101 links.

I hereby certify that the above is a true & correct plot & minutes of survey

Geo. B. Sturtey
District Surveyor
G. C. Wis -