


Survey made for James Hatcher of the N<sup>1</sup>/<sub>2</sub> of the S<sup>1</sup>/<sub>4</sub> of Section No 14 - T4 - R6 west of the 4<sup>th</sup> Principal Meridian; September 21<sup>st</sup> 1848

S<sup>1</sup>/<sub>4</sub> of Sec 14 - T4 - R6 -  
40.14 chs

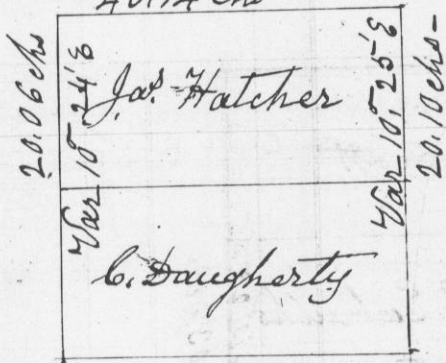

Commencing at Centre post - bearings  
 W. 0.22 N 23° E 72 links = Br. 0.14 S. 36° W 126 links  
 Thence East 40.14 links to 1/4 post - on east side of section. Thence South 40.20 chains to Section corner - corrected back 20.10 links - set 1/16 post in prairie, marked 1/16 S. Thence West to 1/16 post; corrected & took bearings, Br. 0.20 S. 38° E 167 links. Br. 0.18 N 21° W 408 links; Thence North 20.06 links Var 10° 24' E. to the place of beginning.


I hereby certify that the above is a true plot & correct minutes of survey

Geo. R. Stuntz  
District Surveyor  
G. C. Wis

Dr Stephen Mahood  
Deputy

Survey made for Christopher Daugherty of the S<sup>1</sup>/<sub>2</sub> of the S<sup>1</sup>/<sub>4</sub> of Section No 14 - T4 - R6 west of the 4<sup>th</sup> Principal Meridian; Sept. 21<sup>st</sup> 1848

S<sup>1</sup>/<sub>4</sub> of Sec - 14 - T4 - R6 -  
40.14

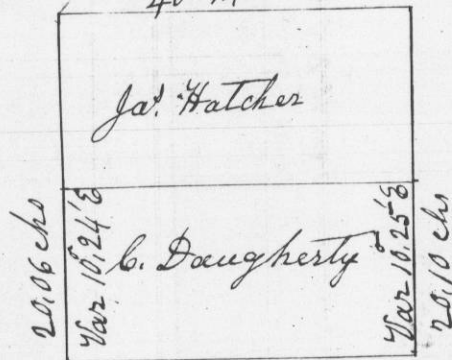

40.08 chs

Commencing at the 1/4 post on South Side of section  
 Original bearings Br. 0.12 S. 22° W 339 links - W. 0.26 S 23° E 387 links - Thence East 40.08 chains to Section Corner  
 Thence North 20.10 chains - <sup>To 1/16 post</sup> Var 10° 25' E - Thence West to 1/16 post bearings, Br. 0.20 S 38° E 167 links. Br. 0.18 N 21° W 408 links. Thence South 20.06 links to the place of beginning

I hereby certify that the above is a true and correct plot & minutes of survey

Geo. R. Stuntz  
District Surveyor  
G. C. Wis

Dr Stephen Mahood  
Deputy