


Survey made for John Rosalip and Henry Fries in Section No 22 in Township No 3 North of Range No 1 West of the 4th M. Corners all established by running from quarter post to quarter post and through South West quarter as the law directs and as shown by the following diagram

Plot of Sec No 22 in T. 3. R. 1. West

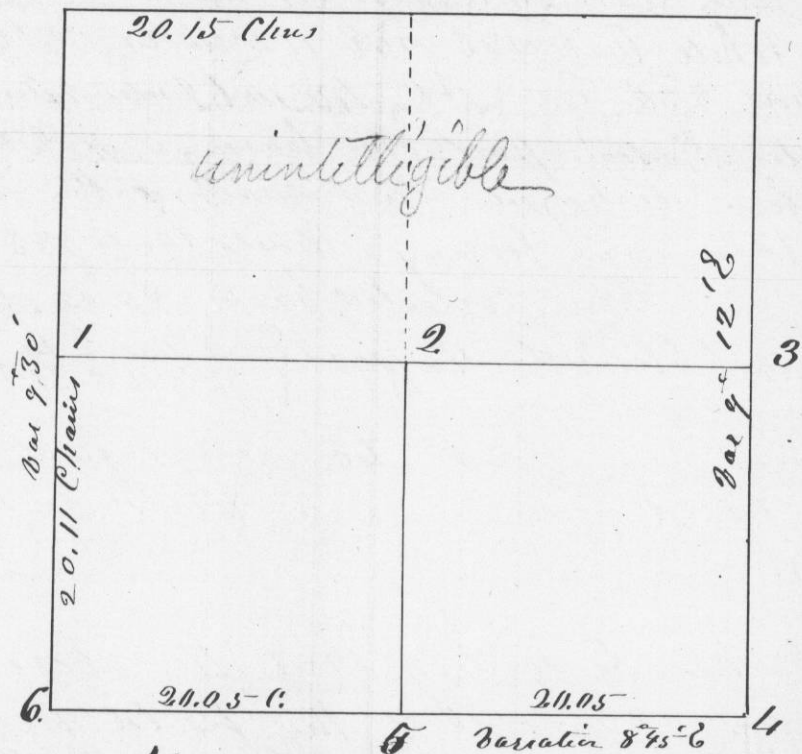


Corners. At 1. Made mound Bearing Blue Oak 88 29 N 41 W. Pink all the other corners are posts set in mounds.

A true record

Attest — Geo. R. Stuntz
District Surveyor
of S. C. Wis

Survey made for John Rosalip of the North West quarter of Section No. 27 in Township No 27 in of Range No 1 West of the 4th principal meridian. The center established by running from quarter post to quarter post as the law directs.

Plot of Sec 27 T 3 R 1 W.

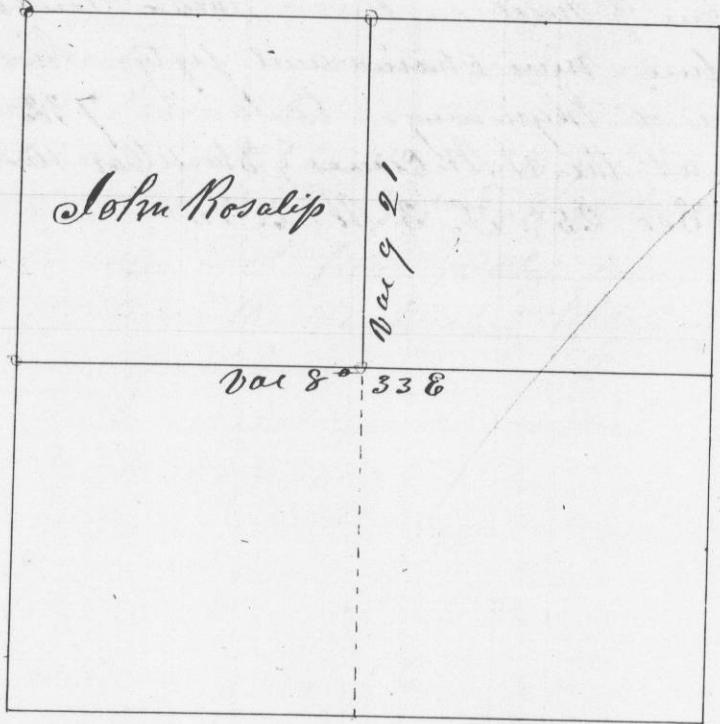

Bearings in the center } Black Oak 9 S 73 W 3 links
Black Oak 9 N 46 W 33

A true Record

Attest — Geo. R. Stuntz
Dist. Surv. of S. C. Wis