


Survey made for Peter Joseph Sheiffman & John Berger in the S.E. 1/4 of Section No. 12- T2- R3 west of the 4th Principal Meridian
 1/2 of Sec-12- T2- R3-

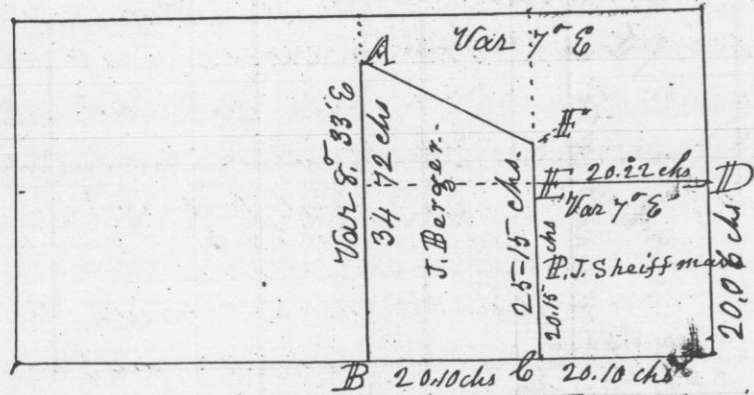

Commencing at the 1/4 post on the north side of Section & run thro' to 1/4 post on south side 80.56 chs. Thence East 40.20 chs to Section Corner; thence north to 1/4 post 40.12 chs; thence west 80.47 chs to 1/4 post on west side of Section. Corrected back to Centre = Thence South 5.50/100 chs & set post A; Thence South 34.72 chains to 1/4 post B; Thence East 20.10 chs. set 1/8 post C; Thence north 40.30 chs to 1/8 post East of Centre; Thence from 1/16 post D. to 1/16 post on west side of said S. E. 1/4; 40.45 chs corrected back and set 1/16 post E; Thence north 5 chs & set post F; Thence N

66° W to post A = Corners & Bearings

A W. O. 17 5 64 1/2 W 37 links	} D W. O. 18 5 63 W 118 links
W. O. stump 18 5 60 E 56 "	
B Original W. O. 24 5 28 W 26 "	} E B. O. 13 N 18 E 96 "
" " 22 " 70 E 50 "	
C W. O. 18 5 22 1/2 E 33 links	} F W. O. 18 5 53 " 145 "
no other	

I hereby Certify that the above is a true & correct plot & Record of Survey made by me this 29th day of May 1849

Geo. B. Stuntz
 District Surveyor
 G. C. Wis
 Pr Stephen Mahood
 Deputy

Survey made for Nelson Dewey
 Commencing at the South West Corner of Section No. 34 in Township No 3 North of Range No. 3 West of the 4th Principal Meridian; Var. 8° E. Thence Run North on Section line to the North West corner of Lot No. 208 - Bearings { White Oak 12 N 62 E 59 links
 White Oak 18 8 25 E 91 links

Thence run East 10.00 Chains to the North East Corner of out lot No. 207 - Bearing White Oak 25 N 38 1/2 W. 28 links. Thence marked a line south to the rear line of in lot No. 11.

I hereby certify that the above is true record of the field notes of said Survey made by me May 5th 1849
 Geo. B. Stuntz
 Dist Surveyor
 G. C. Wis.