

Corners established

- at 7 { White Oak 18 S 62 E 102
Elm 14 N 7 W 76 links
- at 8 { White Oak 9 N 48 E 61 1/2 links
White Oak 12 N 25 E 89 links
- at 9 { White Oak 18 S 79 E 30 links
White Oak 20 N 86 W 33 links
- at 10 { Blue Oak 14 N 56 W 29 links
Sugar 9 N 88 1/2 E 23 links
- at 11 { White Oak 13 S 14 1/2 E 32 links
White Oak 20 N 87 1/2 W 64 links
- at 12 { Black Oak 5 S 34 W 25 links
White Oak 18 N 56 W 22 1/4
- at 13 { White Oak 9 N 42 E 32 links
Black Oak 9 N 11 W 52 links
- at 14 { White Oak 15 N 45 W 84 links
White Oak 14 South 50 links

I hereby certify the foregoing and above is
a true record of the survey made by me in
Sections 10 & 11 on the 4th & 5th days of June 1849

Geo. H. Stantz
District Surveyor of
Grant, Co., Wis.


No. 592

Survey made for Simon Robt of the South
West quarter of Section No. 2 in Township No. 3 North
of Range No. 2 West of the 4th principal Meridian

Commencing at the quarter section post
on the West side of said section Thence East
Variation 9° E. at 79.50 Chains Intersected
Section line 1/4 links North of quarter post corner
on East side of said Section Thence Collected back
Variation 84° 2' E. 39.75 Chains and set quarter section
post in the center of said Section Bearings { Sugar
9 N 28 W 44 links. Thence run South Var 9° 30' E.

at 40. Chains Intersected Sec. line 26 links East of 1/4 Sec.
corner. { Bearings { White Oak 18 S 62 E 102 links
Elm 14 N 7 W 76 links Thence collected
back 20. Chains and set 1/16 post = Bearings
{ W. Oak 12 N 83 E 9 links
{ White Oak 30 N 47 W 13 links Thence run West Var 84°
19. 88 Chains and set 1/16 post in center of S.W.
quarter of said Section - Bearings { Iron 7 N 4 W 33 1/2 links
W.O. 18 S 62 E 55 links

Thence run South Var 9° 10' E 20. Chains
to 1/8 post - previous established by me.
Sec. No. 2 T. 3 North Range 2 W.

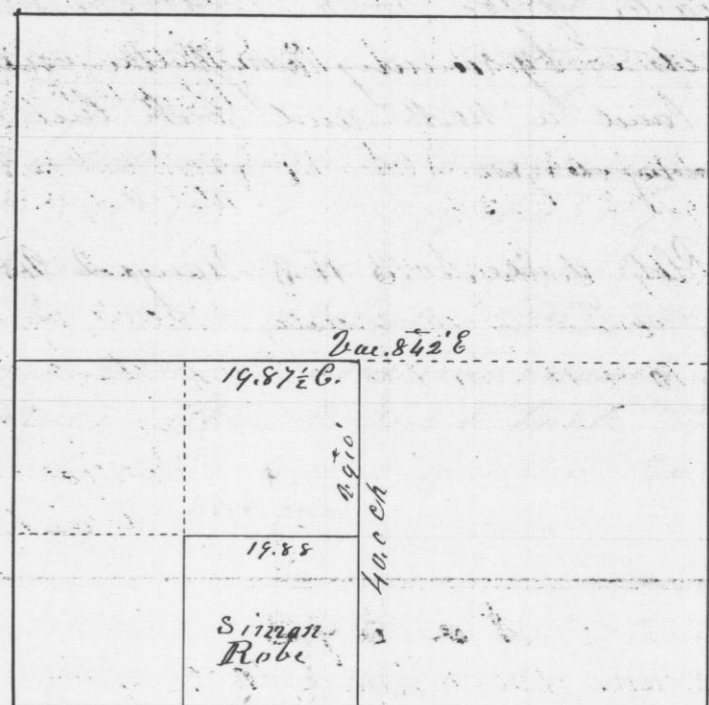

Scale 20 Chains to the inch

I hereby certify that the above is a correct
record of the field notes and plot of said survey
made by me the 6th day of June 1849

Geo. H. Stantz
District Surveyor of
Grant, Co., Wis.