


Survey made for John Kaufman of a lot of land containing  $31 \frac{23}{100}$  acres off from the North End of the NW  $\frac{1}{4}$  of Sec N<sup>o</sup> 32-T4-R5 west of the 4<sup>th</sup> Principal Meridian Nov. 19<sup>th</sup> 1849-

Commencing at the  $\frac{1}{4}$  section post on north side of Section: Thence South (Var.  $9^{\circ}40' E$ ) 6 chains, set post, Thence S  $84^{\circ} W$  (Var  $8^{\circ}40' E$ ) 24.43 links to Burr oak 22 inches diameter Thence West (Var  $8^{\circ}40' E$ ) 15.73 links to Section line (Bearings) Br. Q. 15 S  $79^{\circ} W$  177 links = Br. Q. 15 S  $55^{\circ} E$  254 links - Thence North 8.59 links to Section Corner = Thence East 40 chains to the place of beginning

N  $\frac{1}{2}$  of Sec 32-T4-R5-

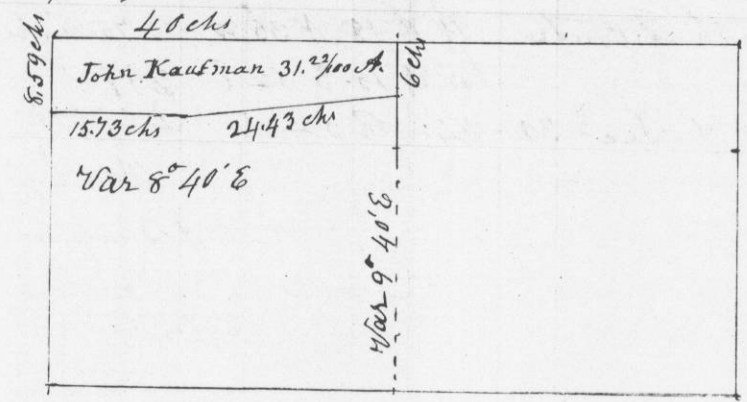

I hereby certify that the above is a true plat & correct record of survey

Geo. R. Stuntz  
District Surveyor  
G. C. W.  
Pr Stephen Mahood  
Deputy

Survey made for William Curtis of a lot of land in Section N<sup>o</sup> 14-T3-R3 west of the 4<sup>th</sup> Principal Meridian Commencing at a point on a line running from the line between Section N<sup>o</sup> 14 above mentioned & Section N<sup>o</sup> 13 of said Town & Range; and 557 links north of the S.E. corner of said Section N<sup>o</sup> 14 & running thence S  $38^{\circ} W$  148 links; on the line of Hudsmith's lot - Thence from said point N  $49 \frac{1}{2}^{\circ} W$  282 links (which includes 100 links at beginning point for Plattville & Potosi Road) Thence S  $38^{\circ} W$  100 links to the N.E. corner of James Eddy's lot Thence S  $49 \frac{1}{2}^{\circ} E$  282 links to said Eddy's South East Corner (which at the last end of said line includes 100 links for above named road) Thence N  $38^{\circ} E$  100 links to the place of beginning - containing in all  $\frac{28}{100}$  of an acre - and Exclusive of road  $\frac{18}{100}$  of an acre = The above described lot adjoins on the East side to a Street 45 links in width, running parallel with East side of said lot - from the North side of said Plattville & Potosi Road

I hereby certify that the above is a true record of survey made this 28<sup>th</sup> day of Sept. 1849

Geo. R. Stuntz  
Dist Surveyor  
G. C. W.  
Pr Stephen Mahood  
Deputy