


No 619 * See 648

Survey made for J. Day of N.E 1/4 of the
S.E 1/4 of Sec 21 of Township No 3 North
of Range No 3 west of 4th principal Mer,
March 13th 1850
Sidman

No 620

Survey made for B. F. Young of the East half of
the South West quarter of Section 31 S. 4 N. Range 1 N.
and of the West 1/2 of the South East quarter for
Joseph Baerlow

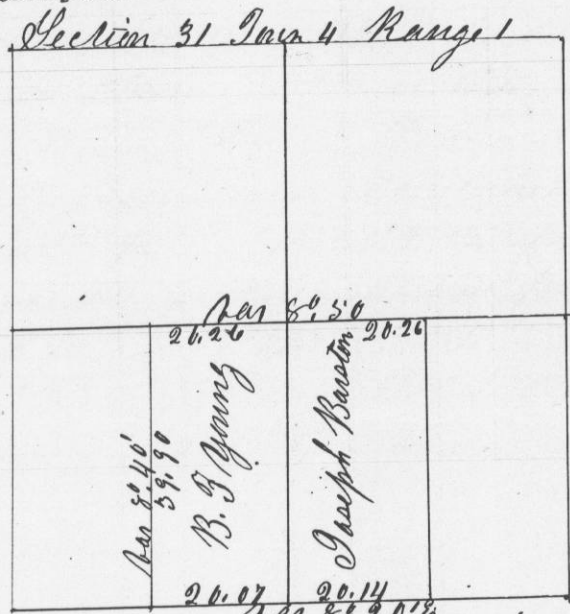

1/8 P S side S E 1/4 section Bearings { Bl 08 99 N 79 1/2
20 do 7 96 9 E 83

1/8 P S side of S N 1/4 section Bearings { Bl 08 96 6 E 144 23

1/8 P N of center Bearings { Bl 06 97 1 E 50 12

1/8 P E of center Bearings { N 020 97 9 E 71 17

1/4 P at center Bearings { N 018 97 6 3 N 198 7 9

A true plat & record of survey.

M. L.