

Survey made for William Wright, Samuel Stevens and Richard Dunstone in Section number fourteen in Township No. 3 North of Range number 3 West of the 2nd principal Meridian in said county of Grant.

Beginning at the North west corner of said Section Thence South $\text{Var } 9^{\circ} \text{ E}$, at 40.00 Chains quarter Section corner beamys?
 Black Oak $7 \text{ N } 32^{\circ} \text{ E } 180$ links at 80.30
 Intersected S.W. Section corner & Black Oak $5 \text{ S } 75^{\circ} \text{ E } 57$ links, Thence run East from $\frac{1}{4}$ Section post on West side of Section Variation $8^{\circ} 30'$ East - 80.36 Intersected Section line 6 links North of post -
 Then run South from quarter Section post on the North side of said Section, $\text{Var. } 9^{\circ} \text{ E}$ at center Intersected interior line 50 links East of Temporary post - 80.20 Intersected Section line 30 links East of $\frac{1}{4}$ Section corner
 Thence run West $\text{Var. } 9^{\circ} \text{ E}$ - 40.18 Intersected Section corner, Corrected back 20.09 Chains and set $\frac{1}{8}$ post & Elm $10 \text{ S } 87^{\circ} \text{ E } 90$ links
 Black Oak $5 \text{ N } 84^{\circ} \text{ E } 51$ links


Thence run North between Dunstone & Wright 20.06 Chains, & established $\frac{1}{16}$ corner between Wright & Stevens, Thence run North between Stevens & Dunstone 20.06 Chains and set $\frac{1}{8}$ Section corner, Then run West between Stevens & Wright - 20.10 Chains and establish $\frac{1}{16}$ post - & Black Oak $10 \text{ S } 52^{\circ} \text{ E } 454$ links

Then Established center of Section for
 Dunstones N.E. corner } Aspen $6 \text{ N } 14^{\circ} \text{ E } 9$ links
 May 29th 1850 } Aspen $8 \text{ N } 77^{\circ} \text{ E } 65$ links

A true record of field notes
 of said survey Geo. R. Huntz
 County Surveyor G.C.Wis.

Survey made for Henry Patch of West half of the South West quarter and the West half of the North West quarter of Section number four in Township number five North of Range No. five West of the fourth principal Meridian

Beginning at the South West corner of said Section Thence East Variation 9° East
 At 39.96 Chains intersected interior line 54 links North of quarter Section corner Thence corrected back True $\text{Var. } 7^{\circ} 30' \text{ E}$ 19.98 Chains and established $\frac{1}{8}$ post in Mound.
 Thence beginning at the quarter Section post on the North side of said Section Variation $8^{\circ} 30'$ East - run West, At 40.24 Chains intersected Section corner, Corrected back 20.12 Chains and set $\frac{1}{8}$ post - Thence run South $\text{Var. } 9^{\circ} \text{ E}$ at 78 + 30 Chains intersected $\frac{1}{8}$ post previously established.

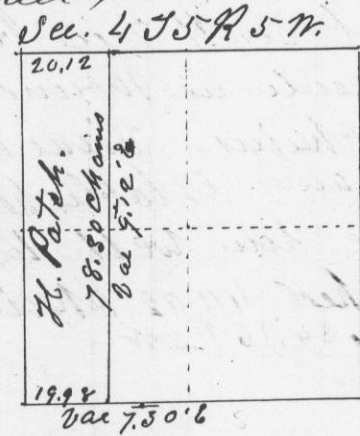

I hereby certify that the above is a true plot and correct minutes of said survey made by me and recorded this sixth day of June 1850
 George R. Huntz
 County Surveyor G.C.Wis.