


Survey made for Jesse Miles Jr - of the S^W/₄ of S^W/₄ of Sec-28-16-R2 West of the 4th Principal Meridian -
S^W/₄ of Sec-28-16-R2-

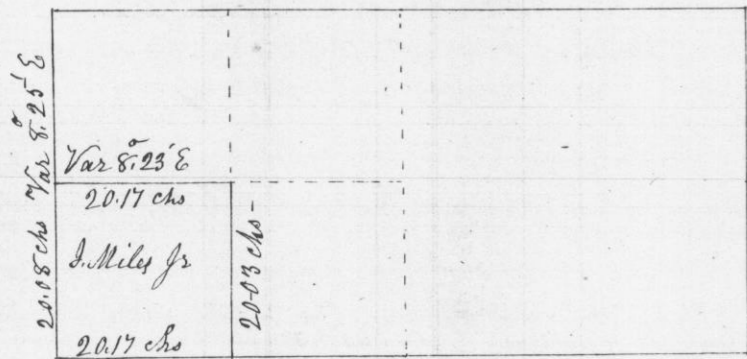


Corners all appropriately marked on Posts and set in Mounds -
Sec- divided by running from ¹/₄ Post to ¹/₄ post as the Law directs
True Variation and distances marked on plot

I hereby certify that the above is a true plot and minutes of Survey
made June 8th A.D. 1850

Geo. B. Stuntz
District Surveyor
G. C. Wis

Pr Stephen Mahood
Deputy

Survey made for John Udelhofen of the N^E/₄ of the S^E/₄ of Sec-13-14-R4 west of the 4th Principal Meridian
S¹/₂ of Sec-13-14-R4-

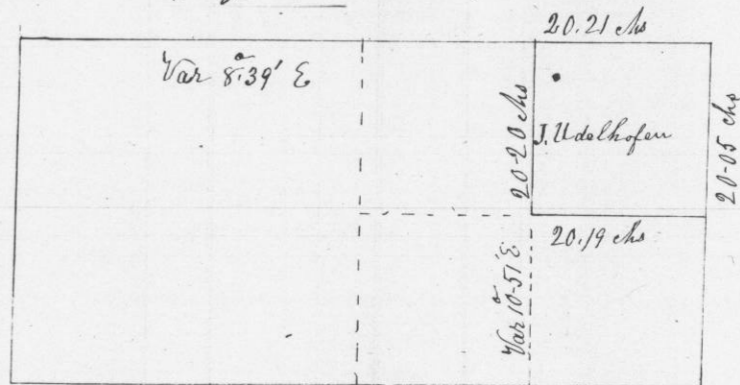

Commencing at S.E. corner of Section; Thence West on Sec-line 40-34 chains to
¹/₄ Post= Thence North (Var 10¹/₂ E) 40.40 chains to Corrected Centre intersected 58
links East of ¹/₄ Post= Thence from ¹/₄ Post on west side of Sec- East (Var 9° E) 40.42
chains from corrected Centre, to ¹/₄ Post on East Side of Sec= Intersected 50 links
North of ¹/₄ Post= Thence South 40.10 chains to place of beginning= Thence Cor-
rected & set ¹/₁₆ Post on East Side of S^E/₄= R. C. 6 N 18° W 45 links= No other --
Thence corrected & marked line from ¹/₄ Post, to corrected ¹/₈ Post, set without bearings
Thence South 40.40 chains (Var 10° 45' E) intersected 12 west of corrected ¹/₈ Post
Thence from ¹/₁₆ Post on west side of said ¹/₄ Sec= East without chaining
Corrected & set ¹/₁₆ Post= R. C. 8 N 5° W 24 links= W. C. 30 S 10° E 42 links= E

I hereby certify that the above is a true Plot & correct minutes of said
Survey made Oct. 22^d 1850

Geo. B. Stuntz
County Surveyor
G. C. Wis

Pr Stephen Mahood
Deputy