


No. 670

Surveyed May 21st 1851 for Timothy Dugan the South half of the North West quarter, and the South West quarter of the North East quarter of Section thirty two in Town one North Range one West of the fourth principal Meridian in the County of Grant and State of Wisconsin as set forth in the following

Plat 4 8

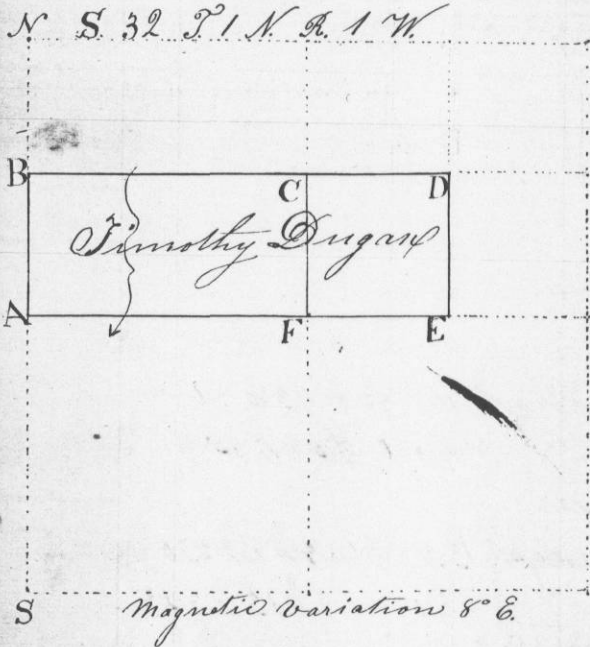

Notes & viz.

Corner at A. (Original) Br O. 14 S. 54° W. 100.

13 B. Stake from which a Black Oak 8 inches in diameter bears North 58° West 265 1/2 links distant as a Br O. 6. N. 42° E. 570.

11 C. Br O. 6 N. 42° W. 258 1/2

... 4. S. 7° E. 459 1/2

18 D. Br O. 6 S. 60° W. 15.

17 E. Br O. 7 N. 74° W. 7639


9 F. Br O. 6 S. 57° W. 10 1/2

I certify the foregoing to be a true record of survey as therein set forth
John J. Everett County Surveyor
Grant Co. Wis.
By C. J. Overton Deputy

No. 671.

Surveyed May 22nd 1851 for Bernard Shuttler the North half of the North West quarter of section thirty two in Town one North Range one West of the fourth principal Meridian in Grant County State of Wisconsin as set forth in the following

Plat 8 Notes viz

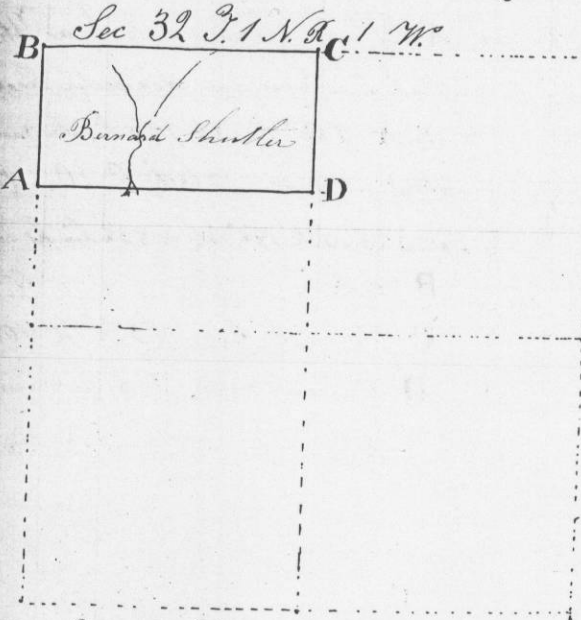

Corner at A. Br O. 8 N. 58° W. 265 1/2 links }
13 Br O. 6 N. 42° E. 570 }

B. (Original) Yellow O. 18 S. 1° W. 595 }
Br O. 13 N. 79° W. 333 }

C (Original cor) Br O. 12 S. 56° E. 225 1/2
" 12 S. 1° E. 289 }

11 D Br O. 6 (marked @ N.S.) N. 42° W. 258 1/2 }
Br O. 4 " " S. 7° E. 459 1/2 }

All bearing trees except "Original" have this (⊕) mark

Magnetic variation 8° East.

I certify the foregoing to be a correct record of survey as therein set forth
John J. Everett County Surveyor
Grant Co. Wisconsin
By C. J. Overton Deputy