


No 672

Surveyed May 22nd 1851. for Theodore Bosman the East half of the South West quarter of Section thirty two in Town one North range one West of the fourth principal Meridian in the County of Grant and State of Wisconsin as set forth in the following

Plat

Sec. 32 T. 1 N. R. 1 W. 4th M.

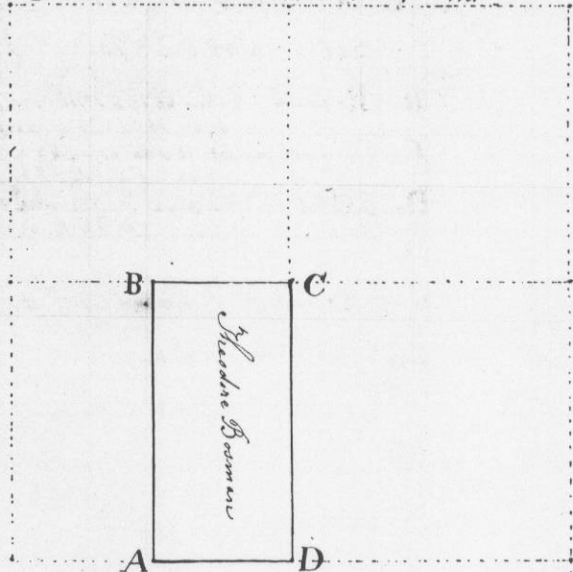

Magnetic variation 8° Easterly

I certify the foregoing to be a correct record of Survey as therein set forth

John J. Everett County Surveyor Grant Co Wisconsin

By C. J. Overton Deputy


Notes vid. Corner at A. Stake from which a White Oak 3 inches in diameter bears North 28 $\frac{1}{2}$ ° East 124 links (marked $\frac{1}{16}$) - also, Black C. 20 in (marked $\frac{1}{16}$) bears N. 19 $\frac{1}{2}$ ° W. 483 $\frac{1}{2}$ links distant B Post C. Black C. 6 in S. 57 $\frac{1}{2}$ ° W. 10 $\frac{1}{2}$ D Original corner Post in Mound

No. 673

Surveyed May 22nd 1851 for Bernard Brunig the North East quarter of Section thirty three in Town one North range one West of the fourth principal Meridian in the County of Grant and State of Wisconsin as set forth in the following

Plat

S. 33 T. 1 N. R. 1 W. 4th Meridian

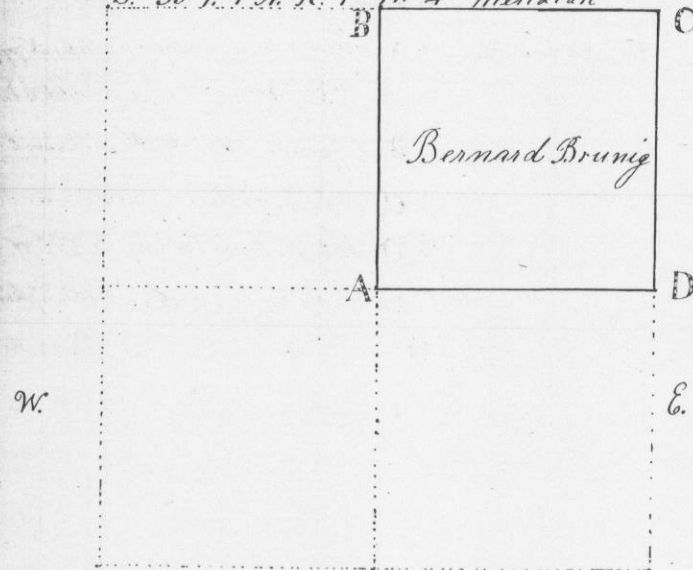

Magnetic Variation 8° East

I certify the foregoing to be a true record of Survey as therein set forth

John J. Everett County Surveyor Grant Co Wisconsin

By C. J. Overton Deputy

Notes vid. Corner at A B. C. 4 N. 33 $\frac{1}{2}$ ° W. 4 links dist (marked $\frac{1}{16}$) B. (Original) Post in Mound C. (Original) B. 0. 10 S. 35° W. 567 links W. 0. 7. 5. 43 W. 7. 43 D Original B. C. 6. 1. 7. 8° E. 43