


No. 720

State of Wisconsin County of Grant March 21st 1853
Surveyed for Henry Norman part of the North West
quarter of section eleven in Township Three North
range one West in said County of Grant Wis
as set forth in the following plat & notes viz:

Sec. 11 T. 3. N. R. 1. W.

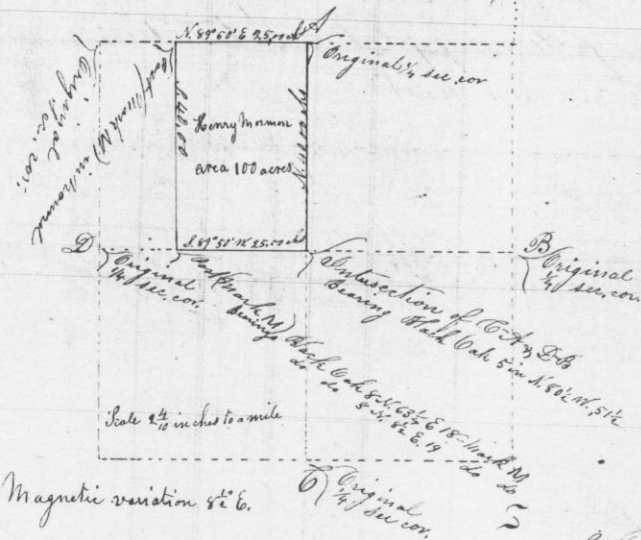


C. D. Overton D. S. & Co. Sur.

No. 721

State of Wisconsin Grant County March 23rd 1853
Surveyed for Edward N. Thomas the West half of the
South West quarter of section two in Township Three North
range one West in the county of Grant Wis as set forth
in the following plat viz:

Sec. 2 T. 3. N. R. 1. W.

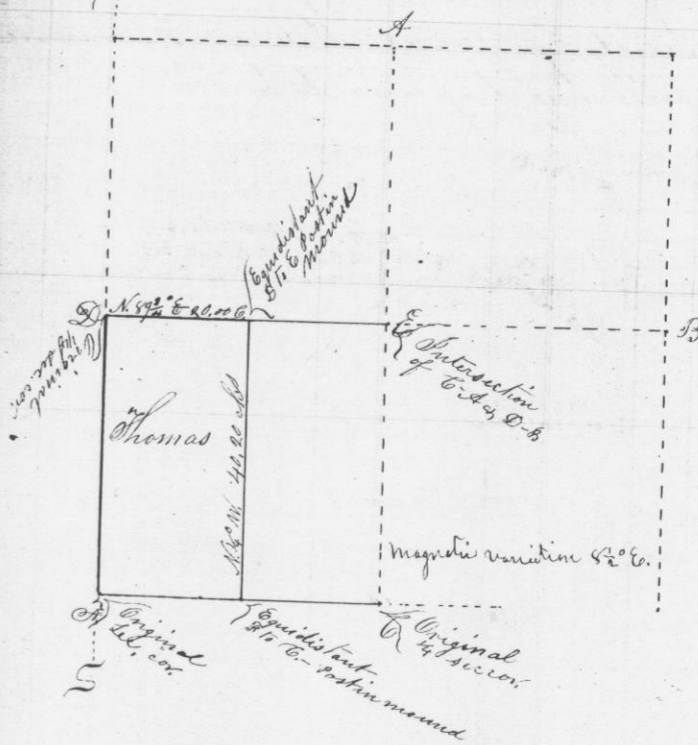

Copy of original notes
C. D. Overton Deputy Co. Sur.