


No. 729

Sept. 26th 1853

Surveyed for William Peter the North East quarter of the South East quarter of section twenty in township two North range One West in the county of Grant state of Wisconsin as set forth in the following Plat & notes thereto:

Sec. 20 T. 2. N. R. 1. W.

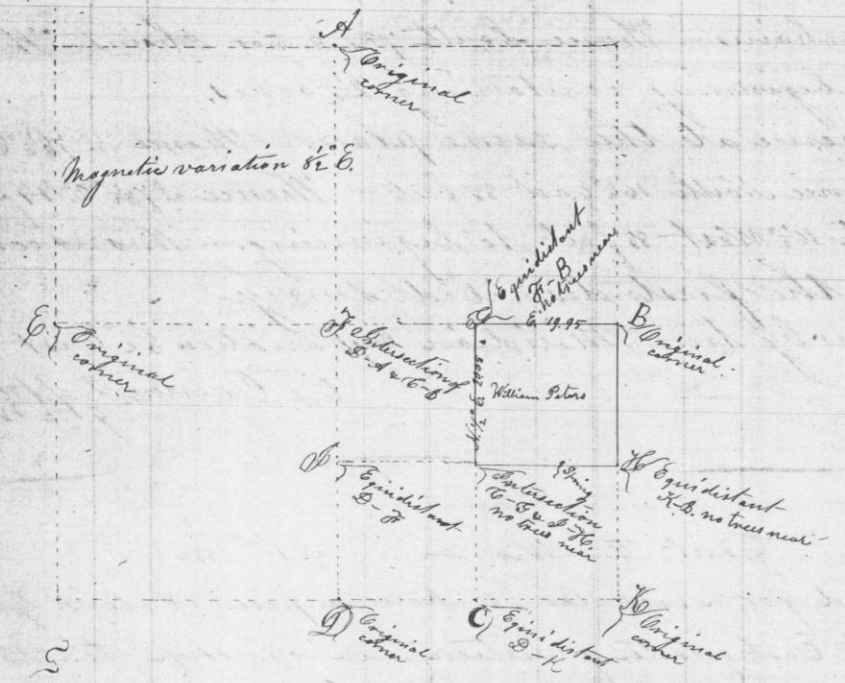

Identify the above to be a true plat & correct copy of original notes of survey


John S. Everett county Surveyor
Wis.
By C. J. Overton Deputy

No. 730

Sept. 26th 1853

Surveyed for John Weyand the West half of the South West quarter of section twenty in township two North range one West in Grant county State of Wisconsin as set forth in the following plat & notes thereto:

Sec. 20 T. 2. N. R. 1. W.

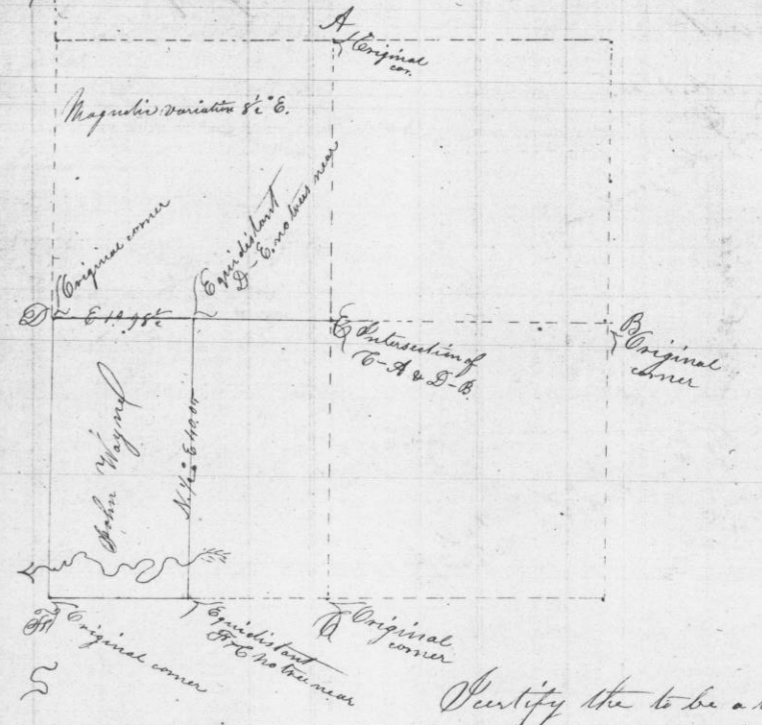

Identify the to be a true plat & correct copy of Original notes John S. Everett Co. Surveyor
Wis.
By C. J. Overton Deputy