


No 795

April 23<sup>d</sup> 1855

Survey for Moses Morse part of section 19 township 3 North range 4 West as shown in the following plat

Sec 19 T. 3. N. 2. W.

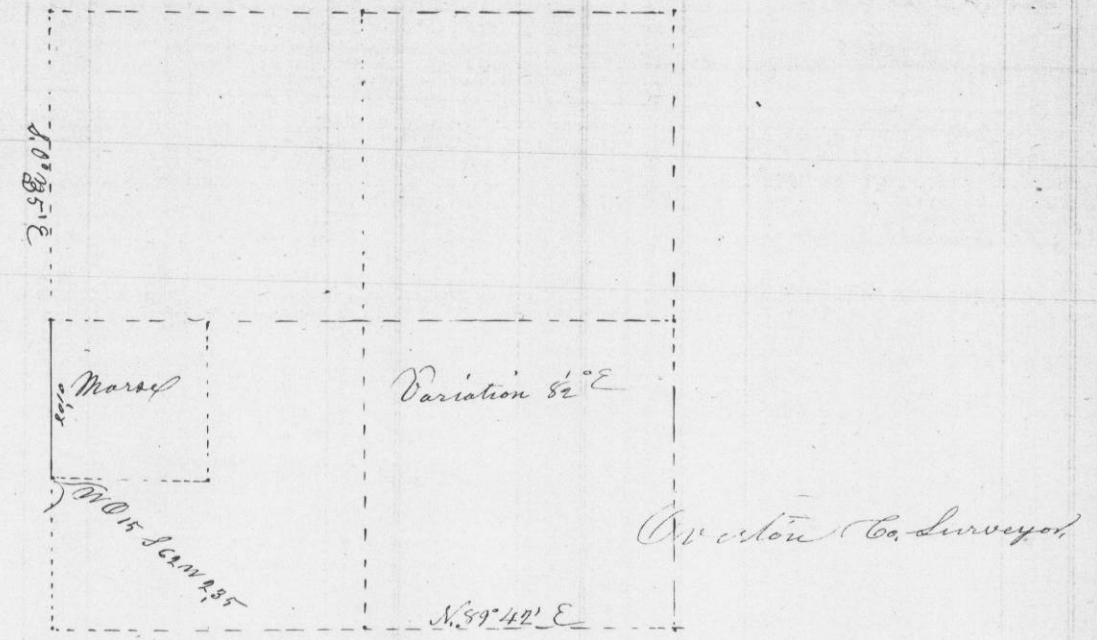


No 798

April 23<sup>d</sup> 1855

Survey for William Robinson Part of section part of section 33 township 3 North range 4 West as shown in the following plat to wit:

Sec 33 T. 3. N. 2. W.

830  
221  
609

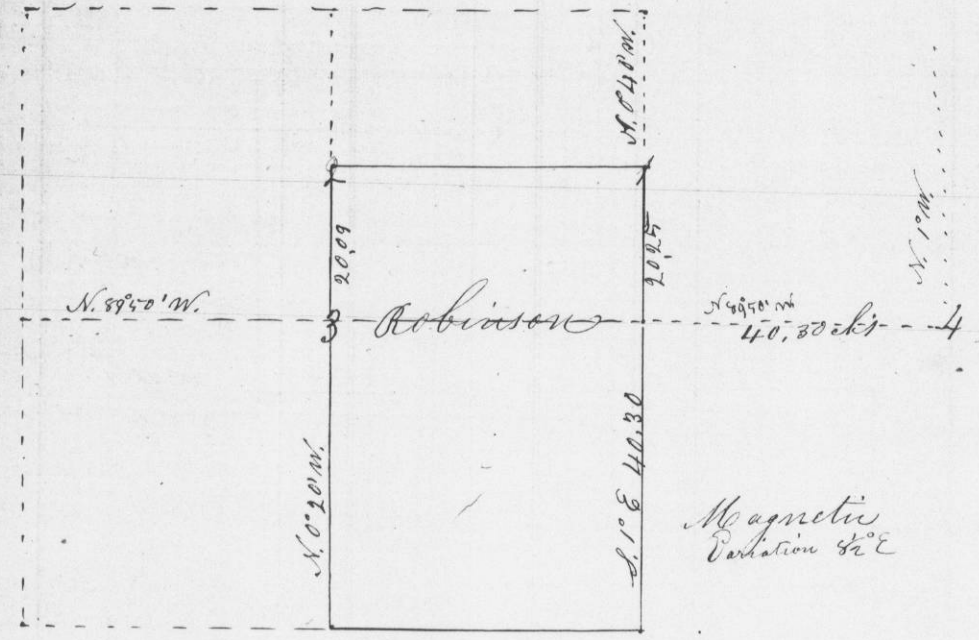

- 1 8014 S 25 1/2° W. 26
- no 7 N 15 1/2° E 51
- 2 81m 10 S 42° E 20
- 3 806 S 76 1/2° E 33
- 4 no 24 N 26 1/2° W 28