


No. 801

May 4th 1855

Survey for Peter Kunkel the East half and South West quarter of the North West quarter of section nine in township one North range one West shown in the following plat to wit:

Sec 9 T.1N. R.1W.

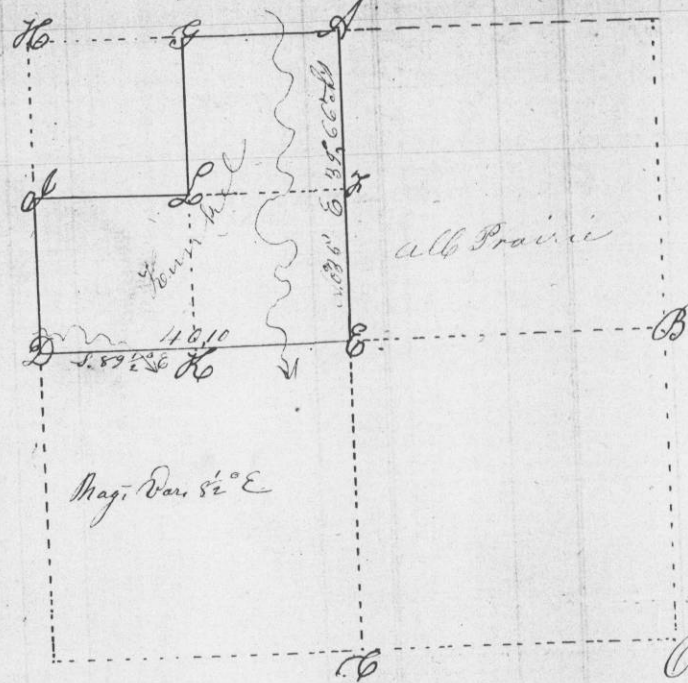

- A - Original corner
- B " "
- C " "
- D " "
- E Intersection of C-A & D-B
- F Equidistant C-A
- G Equidistant H-A
- H Original corner
- I Equidistant D-H
- J Equidistant D-E
- K Equidistant D-E
- L Intersection of K-G & J-F

Overton Co. Surveyor


Mag. Var. 82° E

No. 802

May 4th 1855

Survey for Jacob Hooser & others parts of section 22 in township 3 North range 1 West shown in the following plat to wit:

Sec 22 T.3N. R.1W.

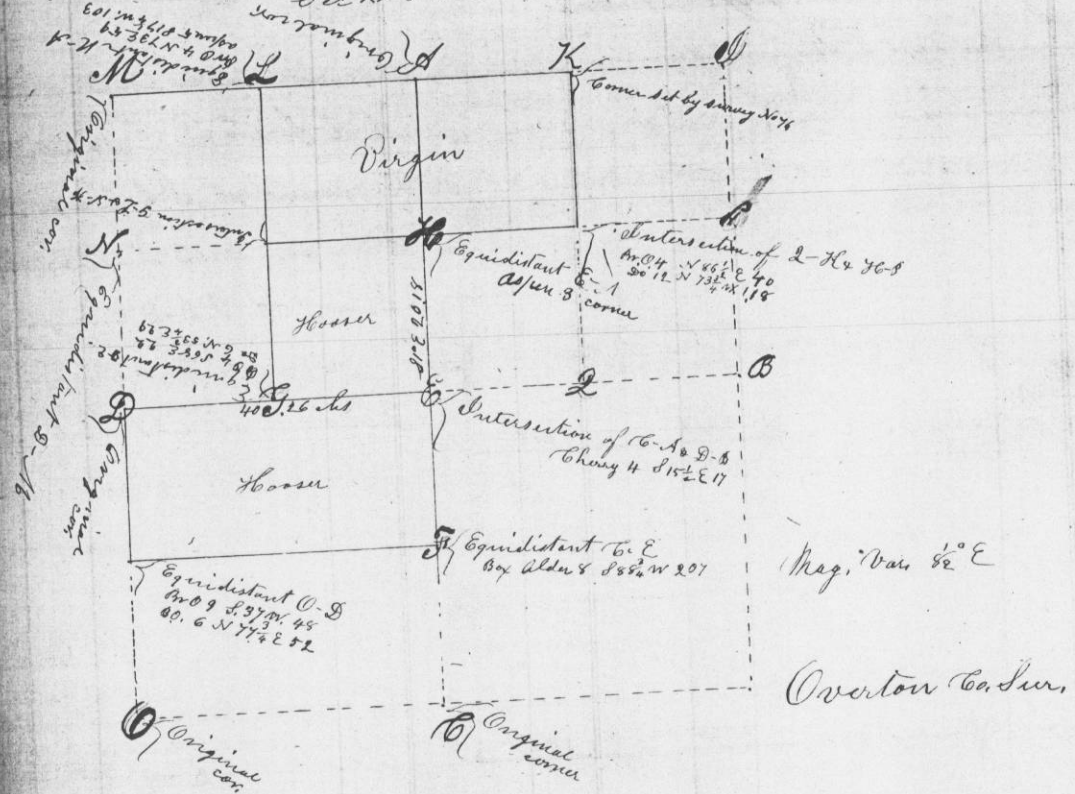

Mag. Var. 82° E

Overton Co. Sur.