


No 807

May 25<sup>th</sup> 1855


Survey for Edward Estabrook the South East quarter of section 23 in township 3 North range one West shown in the following plat to wit:  
Sec 23 T. 3 N. R. 1 W

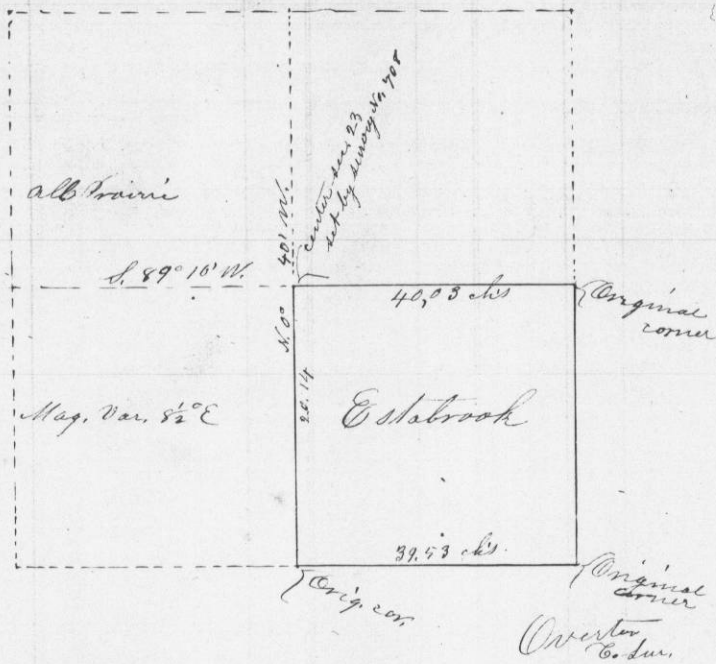

No 808.

June 4<sup>th</sup> 1855

Survey for Carl Hoop & Jacob Carl parts of section 35 in township 3 North range one West & parts of section 2 in township 2 North range 1 West shown in the following plat

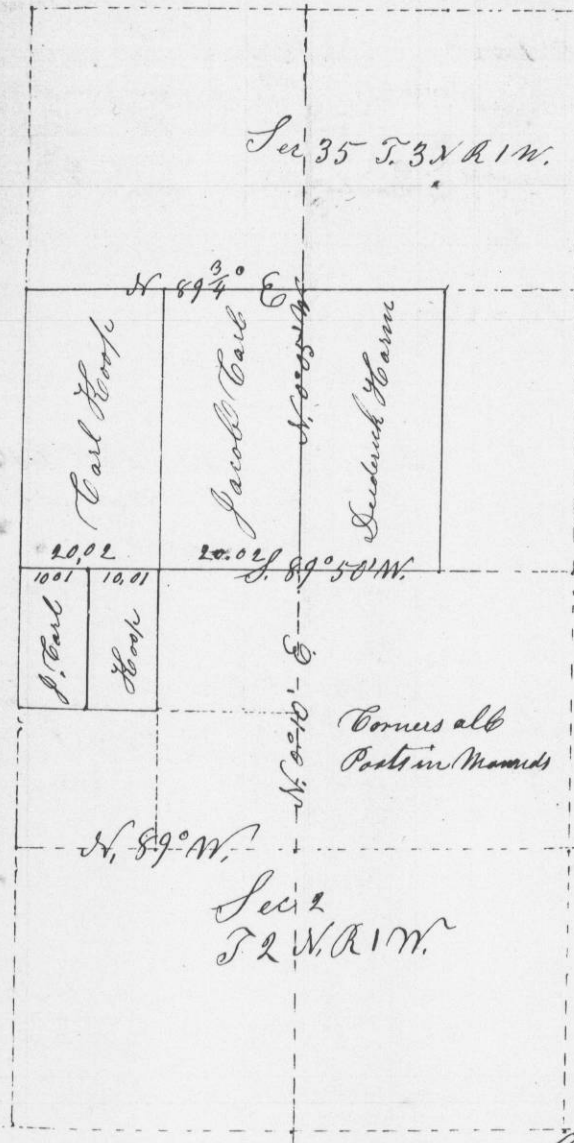

Overtown County Surveyor