


No. 847

and was ^{Feb. 24th 1856} ^{Co. H} ^{parts of section 15}
Surveys for W. W. Wright in township B North Range 3 West shown in the following plat.

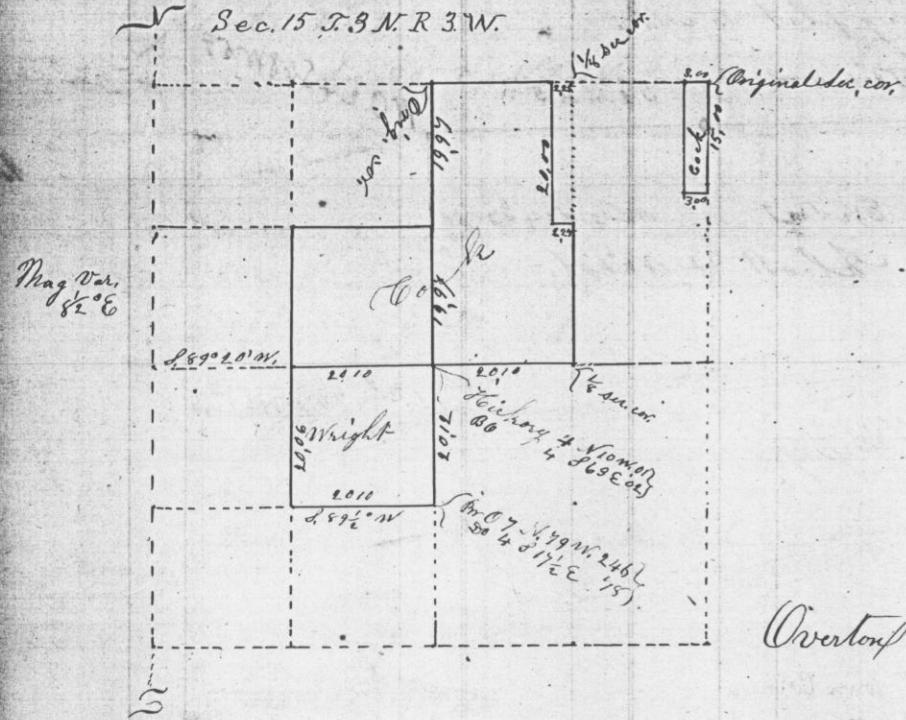

Overton Co. Sur.

No. 848

March 10th 1856

Survey for Joseph Bailie L. D. McKemie & James Oates parts of Section 30 in township five North range three west shown in the following plat viz:

Sec 30. T. 5 N. R. 3 W.



O. S. Overton County Surveyor