


March 12th 1856


Survey for James Oates the North half of the North West quarter and the North West quarter of the North East quarter of section thirty one in township five North range three West shown in the following plat viz:

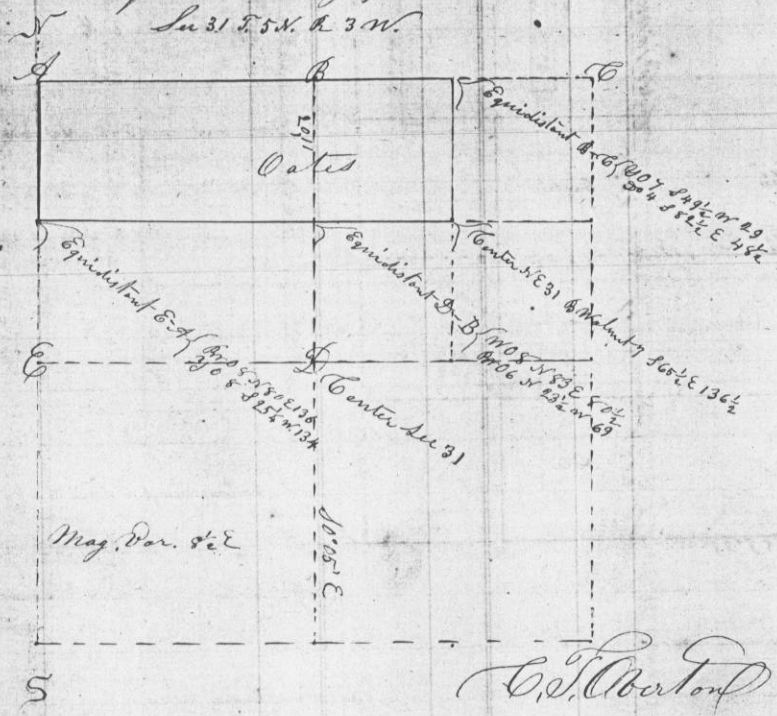

May 3rd 1856

Survey for Eli C. Jones the East half and the West half of the South East quarter of section 14 in township 6 North range one West shown in the following plat viz:

Sec 14 T. 6 N. R. 1 W.

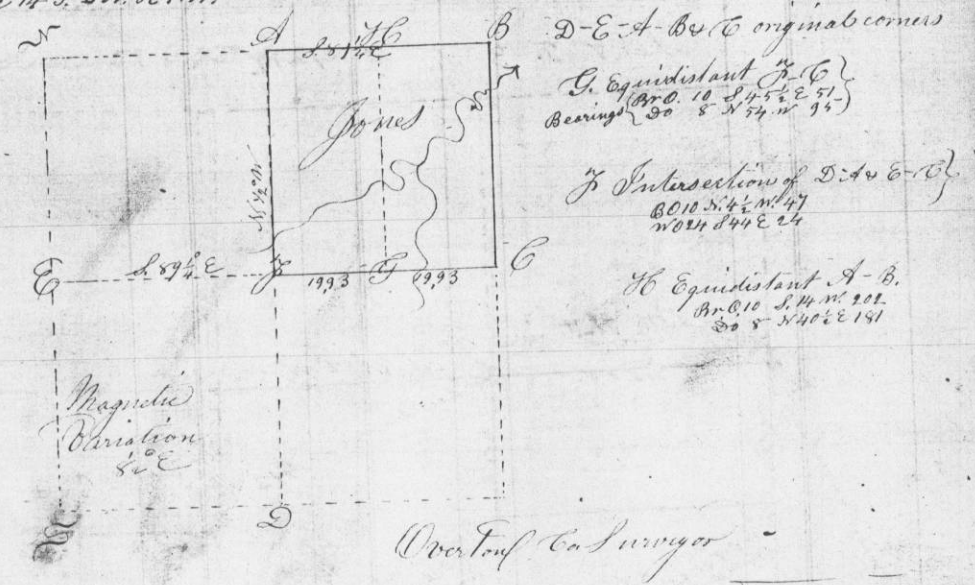

No 850

March 20th 1856

Survey for John V. Hudson the South East quarter of the N.W. 1/4 of sec 10 T. 3 N. R. 2 W. shown in the following plat viz:

