


No 853

April 2nd 1856

Survey for Thomas M^r Govern parts of Section twenty three in township four North range two west - shown in the following plat to wit:

Sec. 23 T. 4 N. R. 2 W.

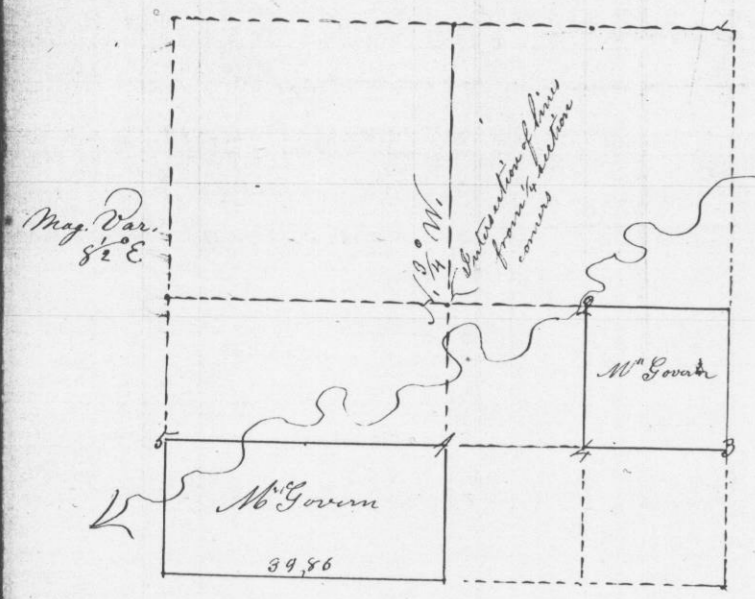

- 1 W. 15 N. 41 1/2 W. 93
Do 12 S. 57 1/2 E. 138 21
- 2 6010 S. 75 1/2 W. 17
Line 10 N. 10 1/2 W. 15 17
- 3 W. 15 N. 10 1/2 W. 20
Do 10 N. 50 1/2 E. 26 19
- 4 6010 N. 20 1/2 E. 34
Do 10 S. 59 1/2 W. 42 22
- 5 6007 S. 55 1/2 E. 275
604 N. 10 E. 67 24


Survey & Recd. by
C. S. Overton Co. Sur.

No 854

April 8th 1856

Survey for Daniel Burton and David Mattison parts of Section 23 in township four North range two west - shown in the following plat to wit:

Sec. 23 T. 4 N. R. 2 W.

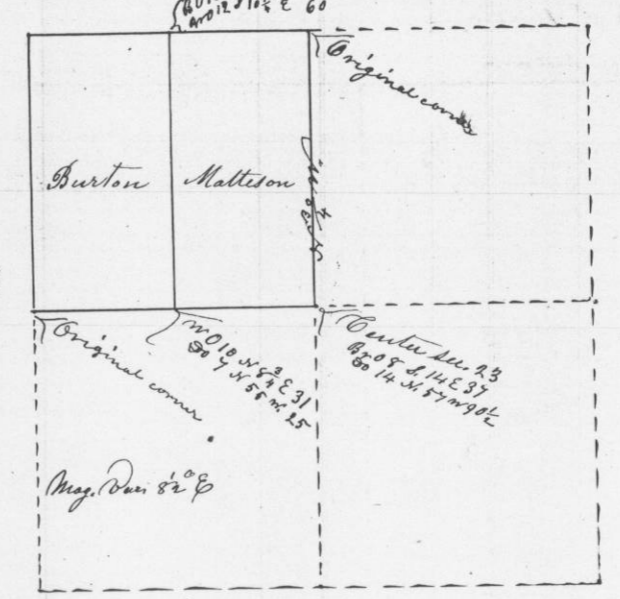

Survey & Recd. by
C. S. Overton Co. Sur.