


No 859

April 29th 1856

Survey for Elisha Blackman the East
half of the South West quarter of section eighteen
in township three North range one west of the
fourth principal Meridian—Shown in the
following plat to wit:

Sec 18 T. 3 N. R. 1 W.

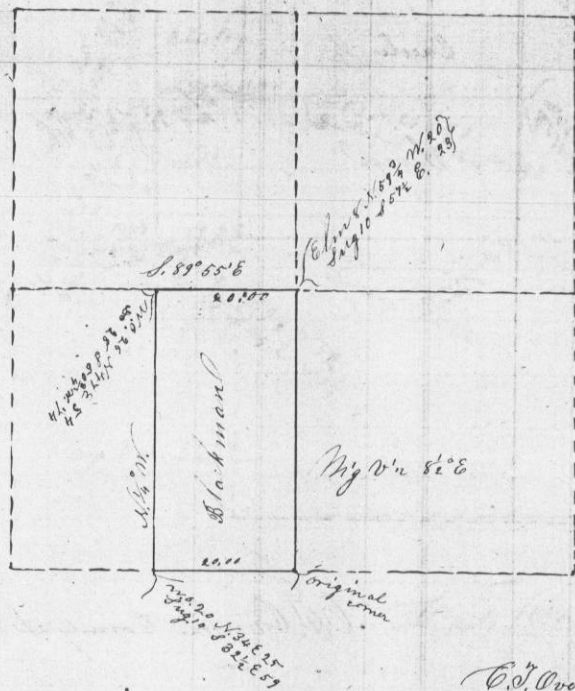

C. J. Overlin County Surveyor

No 860 Sec 85.0