

Nov. 26<sup>th</sup> 1856

Survey for Isaac Burton the West-half of the South West quarter of section seventeen in township five North range one West shown in the following plat to wit:

Sec. 17 T. 5 N. R. 1 W.




C. J. Weston Co. Surveyors

I hereby certify that I this day surveyed the South East quarter of the north west Quarter and a part of the North east Quarter of the South west Quarter of section number twenty two in town two north of Range two west of the fourth Principal Meridian for Andrew Smith and that the courses and lengths of the Boundary lines of said Lots are accurately delineated on the plat below Given under my hand this 14<sup>th</sup> day of June 1862.

By S. Merrick Deputy  
Joseph Allen

County Surveyor.

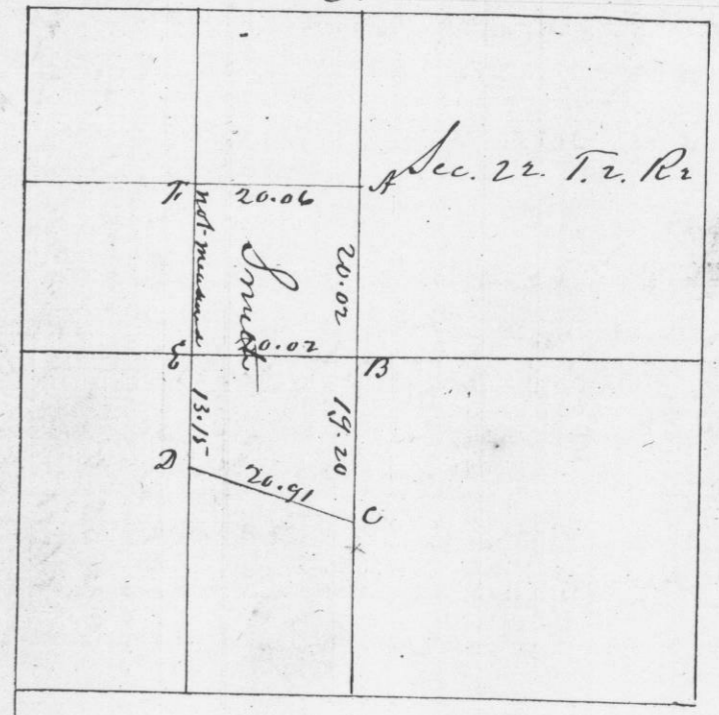

- A. Wh. oak N 41° 45' E 75 } E. Bl. o. 3 S 57° E 26 1/2
- Bun 4 10 S 25° E 77 } T. Bl. oak 6 S 41° E 76 1/2
- B. Bun 0.70 N 70 1/2° E 60 } Wh. o. 4 S 13° E 56 1/2
- W. o. 6 S 60° 15' W 68 1/2
- C near Dickey's House
- D near center of Highway no bearing tree left