


N<sup>o</sup> 52

Record of Survey made for Henry Reuzer by G. W. Hayden, Deputy County Surveyor, of the N<sup>o</sup> 1/4 of Section 16 Township 3 North of Range 5 West 4<sup>th</sup> P. M. on the 29<sup>th</sup> day of April and first day of May 1854. Executed in accordance with the provisions of an act of the Wisconsin Legislature regulating the mode of executing surveys approved April 20<sup>th</sup> 1853. Of which said survey the following is a true and correct plot representing the length of lines, the curved variations of the same and also the bearing trees at the several corners. Alexander Polkinghorn and William Reuzer Chaimmen first duly sworn.

N<sup>o</sup> 1/4 of Sec 16 Town 3 North Range 5 West 4<sup>th</sup> P. M.

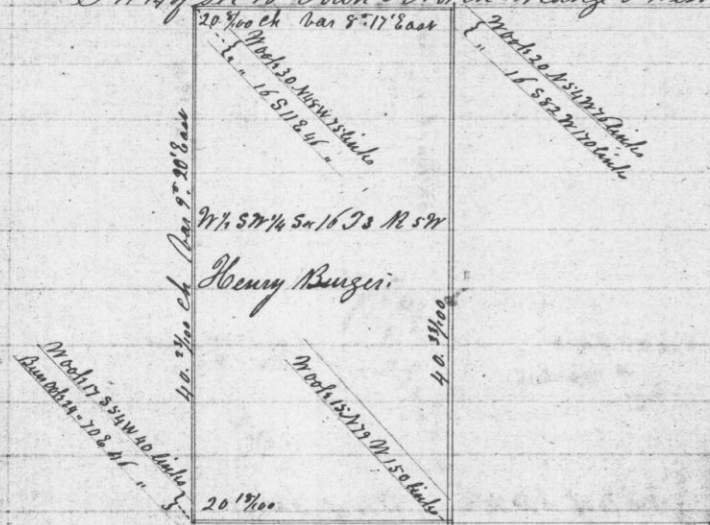


I hereby certify that the above plot & notes are correct as copied from the original  
 May 9<sup>th</sup> 1854 Attest  
 John G. Clark,  
 County Surveyor.

N<sup>o</sup> 53

Record of Survey of N<sup>o</sup> 1/4 of N<sup>o</sup> 8 1/4 & N<sup>o</sup> 1/4 of S<sup>o</sup> 8 1/4 of Section 2 Township 3 North Range 5 West made for William Craig by G. W. Hayden Deputy County Surveyor on the 28<sup>th</sup> day of April 1854. which said survey was executed in accordance with an act of the Wisconsin Legislature regulating the mode of subdividing sections approved April 20<sup>th</sup> 1853. Of which the following is a correct plot.  
 Edward Craig & Elijah Groom Chaimmen first duly sworn.

E<sup>o</sup> 1/4 of Section 2 Town 3 North Range 5 West

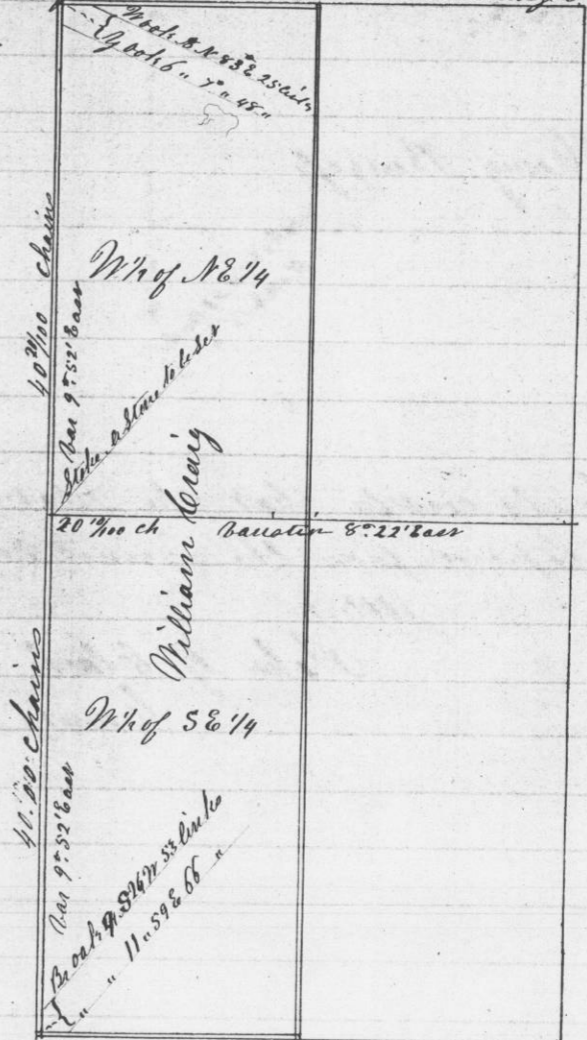

I hereby certify that the above plot & field notes are true and correct as copied from the original notes.  
 May 9<sup>th</sup> 1854 Attest