


N^o 54

Record of Survey made for Henry Burgess of S^W 1/4 of Section 2 Township 3 North Range 5 West by G. W. Hayden Deputy County Surveyor on the 25th day of April 1854.

Of which Survey the following is a true & correct plat Edward Craig and Elijah Groom Chaimmen first duly sworn

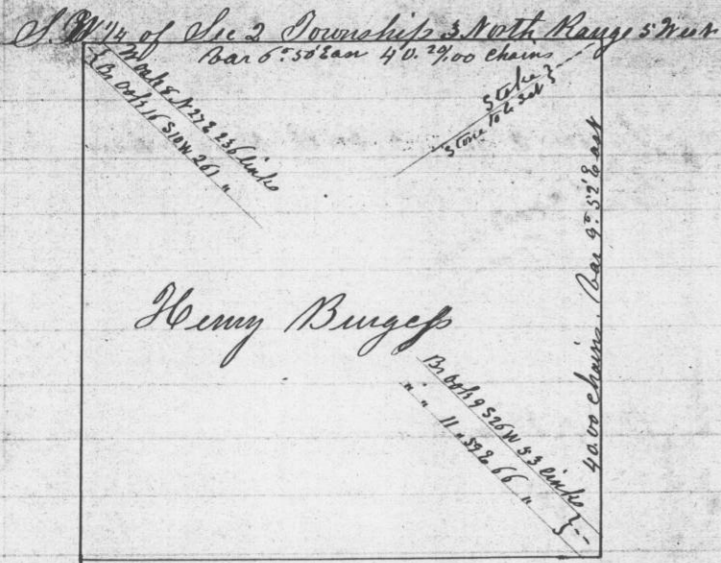

I hereby certify that the plat & notes are correct as copied from the original notes.

May 9th 1854


Attest

John G. Clark
County Surveyor

N^o 55

Record of Survey made April 10th 1854 for Simon Woodhouse of the N^W 1/4 of the N^W 1/4 of Section 1 Township 4 North Range 5 West by G. W. Hayden Deputy County Surveyor

Of which said Survey the following is a correct plat representing the length of lines & variation of same made Headley & Phillip Stevens Chaimmen first duly sworn

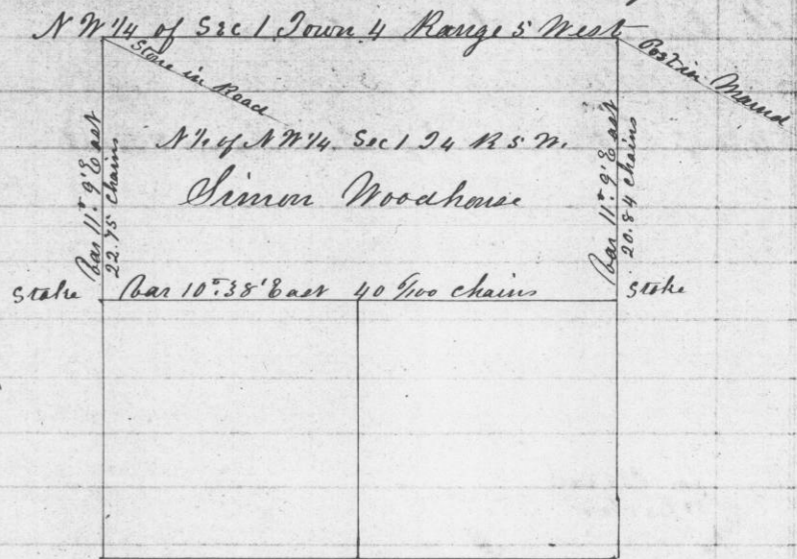

I hereby certify that the above plat & notes are correct as copied from original notes

May 9th 1854

Attest

John G. Clark
County Surveyor