


No 56

Record of Survey made for John Blair by G. W. Hayden Deputy County Surveyor April 10th 1854 of the SW 1/4 of N 1/4 of Section 1 Township 4 North Range 5 West

Mark Headley and Phillip Stevens Chairmen first duly sworn of which said Survey the following is a correct plot representing the length of lines & the variation thereof and also the bearings at the several corners.

N 1/4 of Section Township 4 North Range 5 West

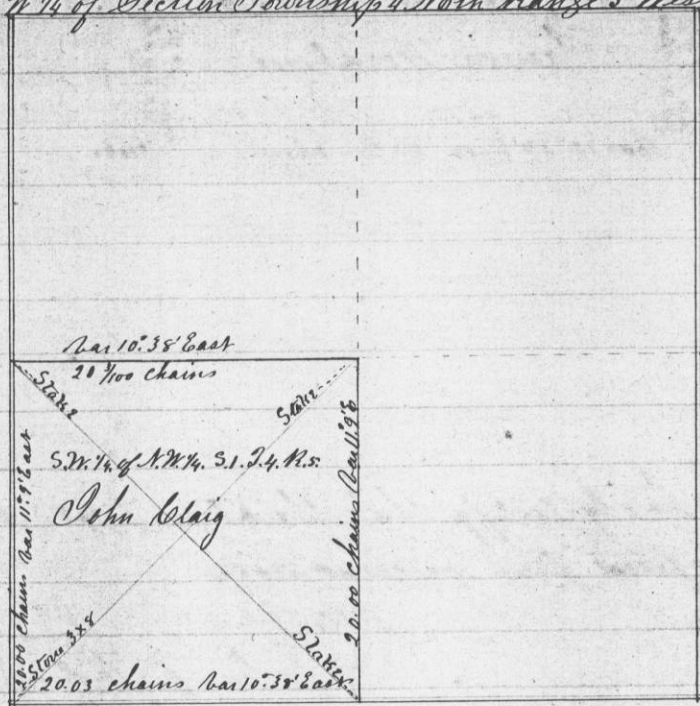

I hereby certify that the above foregoing field notes are correct as copied from the original field notes & plot.

May 10th 1854


Attest

John G. Clark
County Surveyor

No 57

Record of Survey made for Philander Stephens of the South 1/2 of the N. E. 1/4 of Section 1 Town 4 North Range 5 West by G. W. Hayden Deputy County Surveyor on the 10th day of April 1854. of which tract the following is a correct plot representing the length of the boundary lines thereof the cornered variations of the same & also the land marks at the several corners. John Blair and Mark Headley chairmen first duly sworn.

N. E. 1/4 of Section 1 Town 4 North Range 5 West 4th P. M.

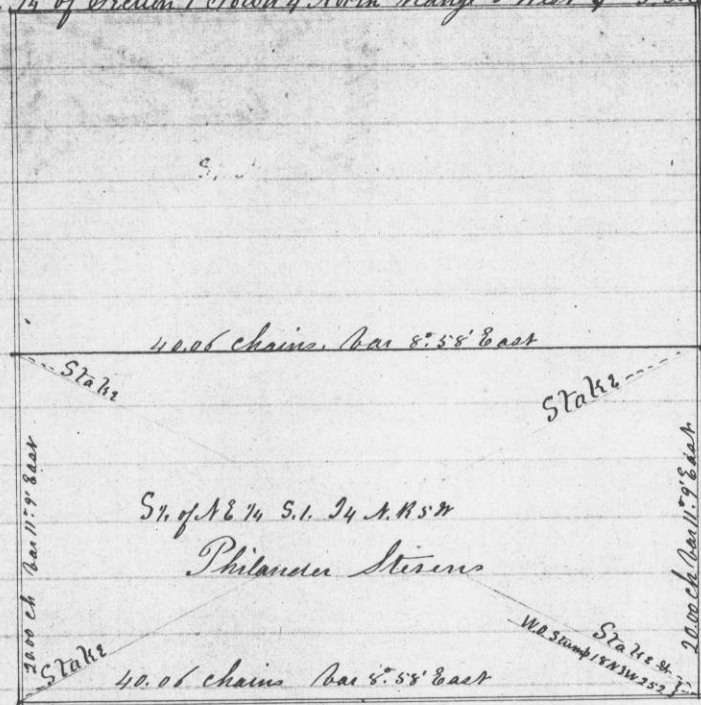

I hereby certify that the above plot and field notes are correct as copied from the original notes.

May 10th 1854

Attest

John G. Clark
County Surveyor