


Record of Survey made for James Buchanan of the S.W. 1/4 of the S.W. 1/4 of the S.W. 1/4 of Section 23 Town 5 North Range 5 West by Solomon Goodrich Deputy County Surveyor April 26<sup>th</sup> 1854

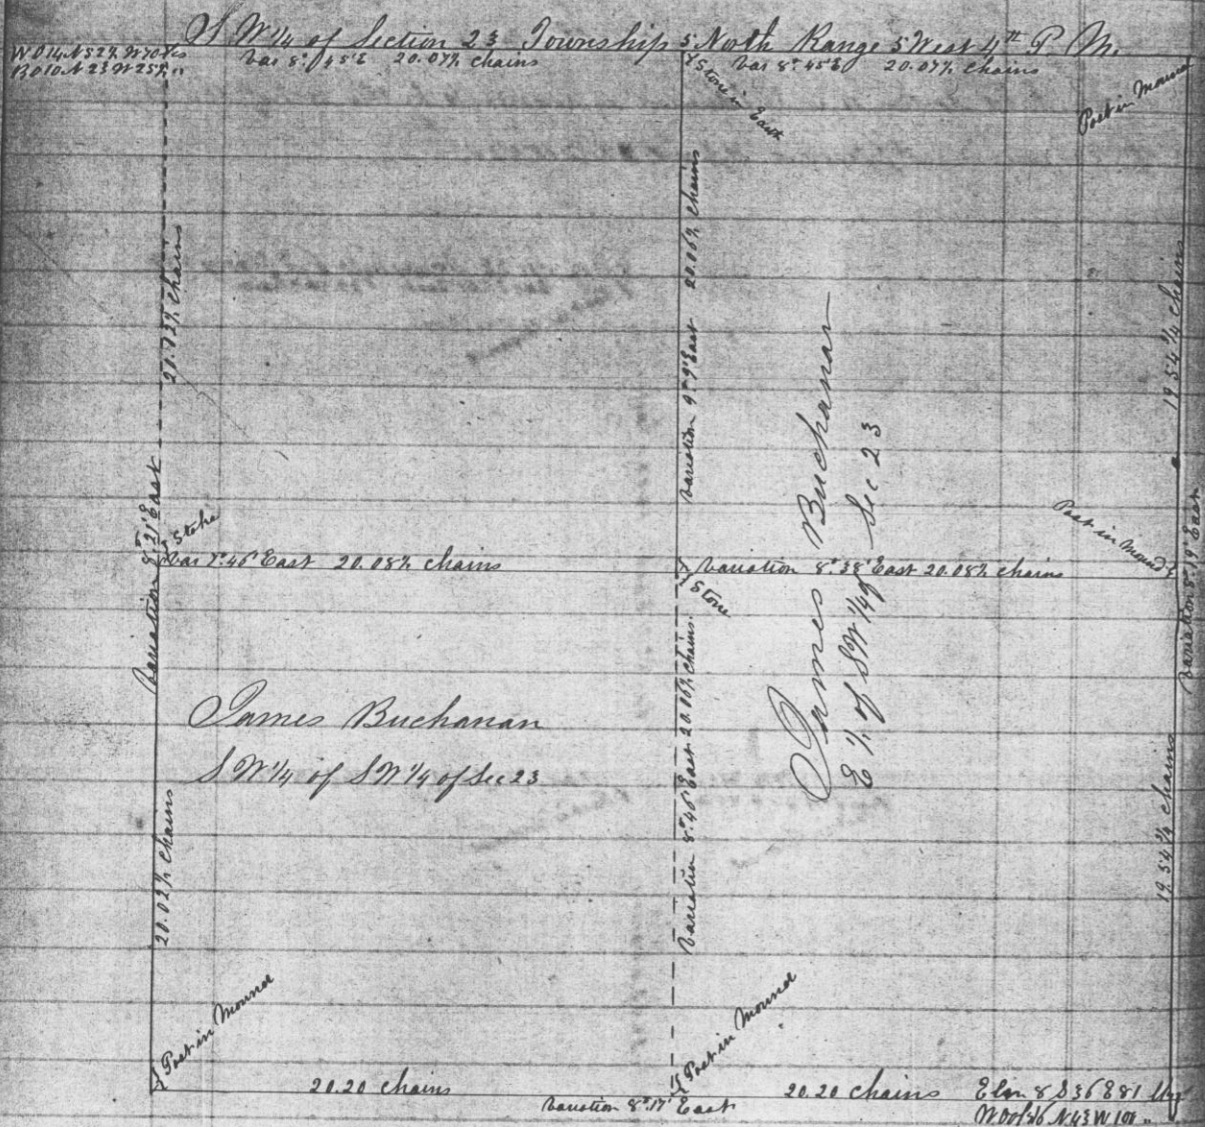


Which said survey was made as required by act of Wisconsin Legislature approved April 22<sup>d</sup> 1853. I hereby certify that the above is a true copy of the original plat & notes of said survey as taken at the time the same was executed. Attest

John G. Clark  
County Surveyor  
Recorded June 7<sup>th</sup> 1854.

Record of Survey made for Frank Wood of the S.W. 1/4 of the S.E. 1/4 of Section 36 Township 5 North of Range 5 West and of a ten acre lot on the East side of the N.W. 1/4 of the S.E. 1/4 of Section 1 Town 2 North Range 5 West April 25<sup>th</sup> 1854. Barnett Greyn and Michael Shields chainmen first duly sworn by Solomon Goodrich Deputy County Surveyor.

Of which said tracts the following is a correct diagram representing the length of the boundary lines thereof & the variations of such as were retraced in making said survey, and the land marks at the several corners thereof.

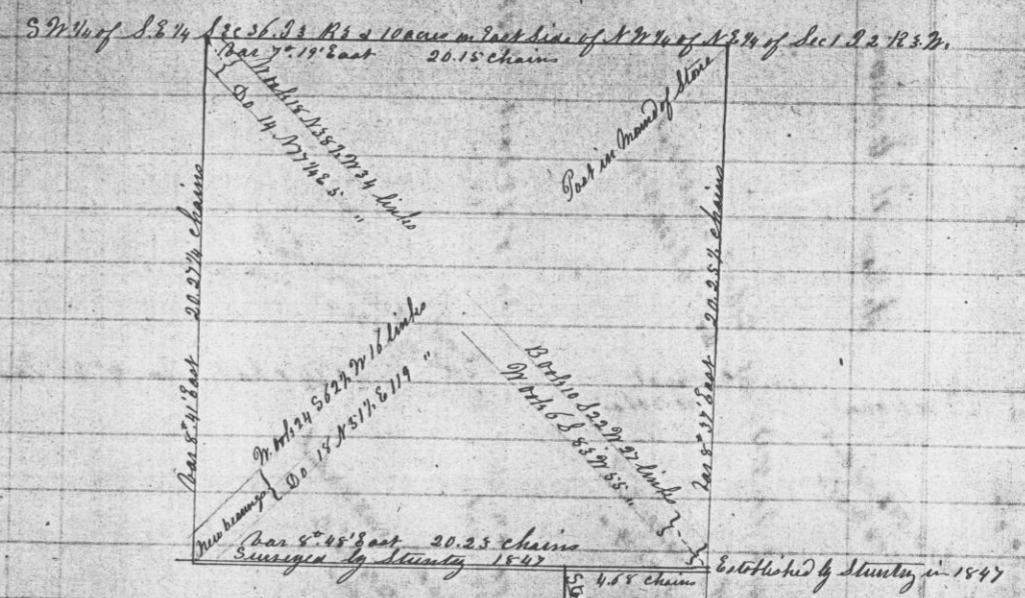

Which said survey in section 36 was made in accordance with the provisions of the Statute requiring the center parts both of the sections and quarter sections to be set at equal distances from the North & South and also at equal distances from the East & West boundaries thereof. The said survey in Section 1 was founded upon survey made by J. R. Stuntz in 1847.

I hereby certify that the above and foregoing is a true record of the original notes of said survey. Recorded June 7<sup>th</sup> 1854. Attest John G. Clark, County Surveyor.