


No 101


Survey made for William T. Connor & Joseph
 Patten June 30th 1854 by Solomon Goodrich Deputy
 County Surveyor of the W¹/₄ of the N²/₄ & the N²/₄ of
 N. E. ¹/₄ of Sec 25. Town 3^d R³ N. James Edwards and
 Joseph Canett. Chainmen first duly sworn.
 Section 25. Town 3. N. Range 3. T²/₂

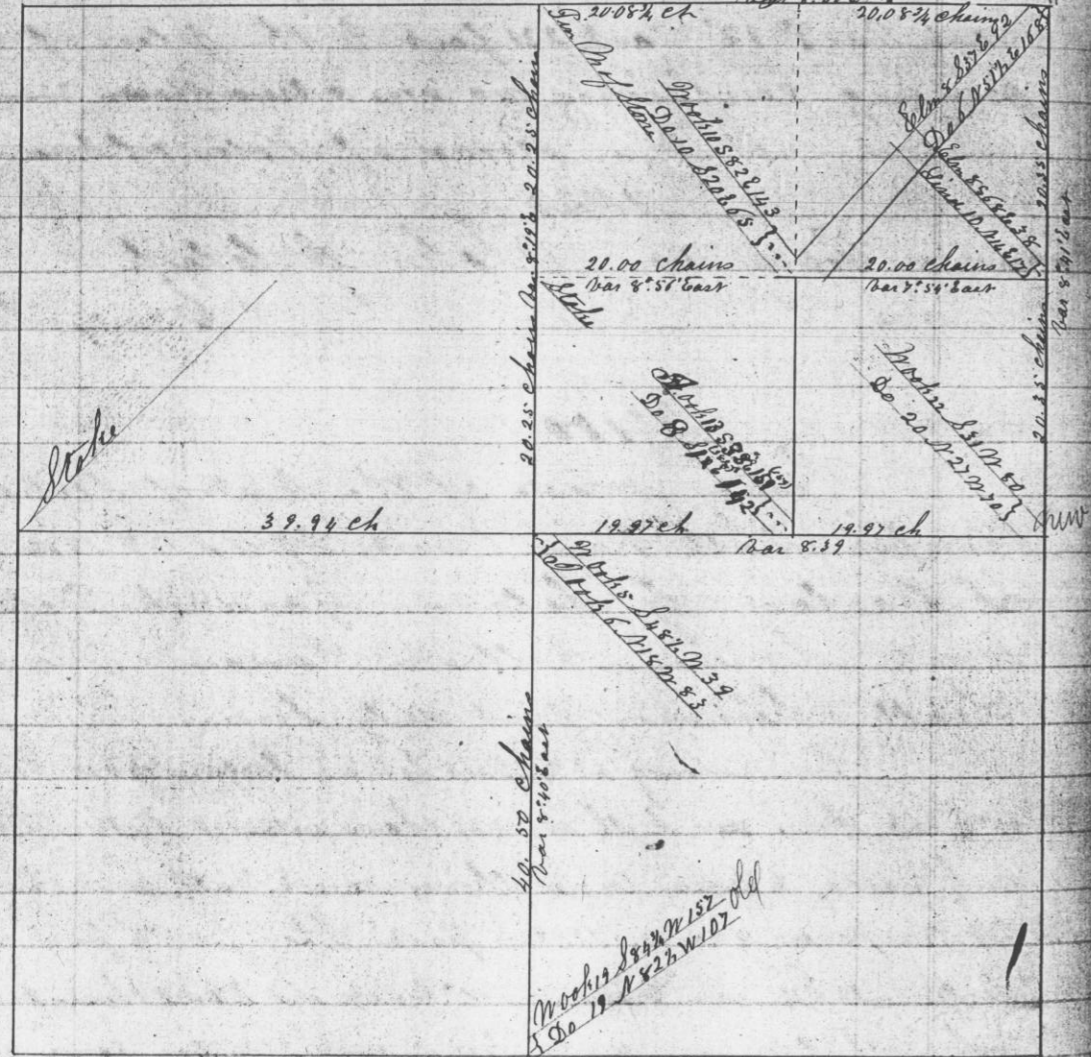

I hereby certify that the above is a correct copy
 of notes of said Survey.
 Attest. John G. Clark.
 County Surveyor.
 Recorded Sep 4th 1854.

No 102

Survey made for William Manning of the
 S¹/₄ of the S. E. ¹/₄ of Section 14 Township 7 North Range 1 West
 August 10th 1854. by Solomon Goodrich Deputy County
 Surveyor. James Donice and Patrick Manning chain-
 men first duly sworn. also a survey for Francis Norris.
 Section 14. Township 7 N. Range 1 West.

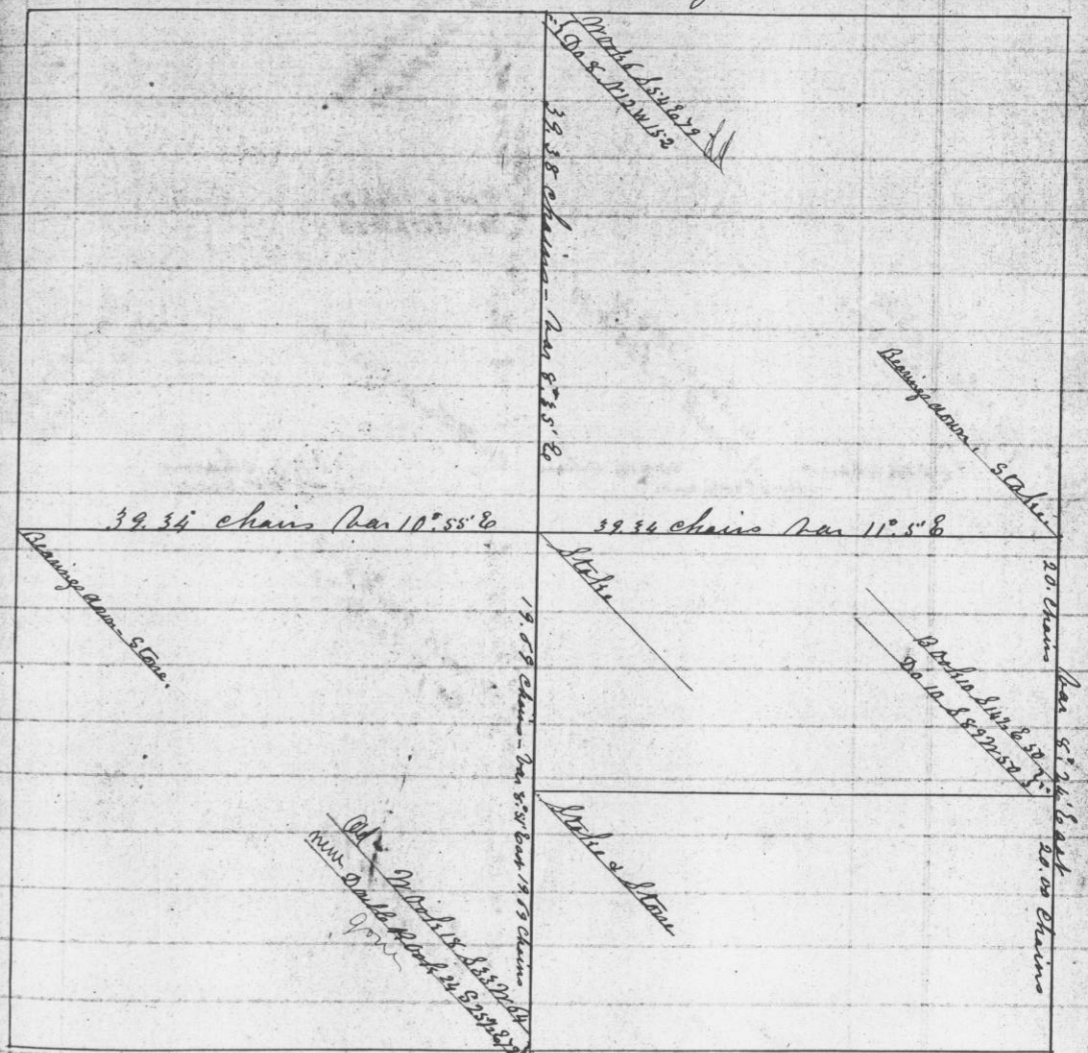

I hereby certify that the above is a correct
 copy of the original field notes.
 Recorded Sep 6th 1854.
 John G. Clark.
 County Surveyor.