


Survey made for Francis Norris in Section 26 Township 3 North Range 1 West August 9th & 10th 1854 by Solomon Goodrich Deputy County Surveyor James Doucay Martin Lemmeger chainmen only sworn Section 26 Township 3 North Range 1 West.

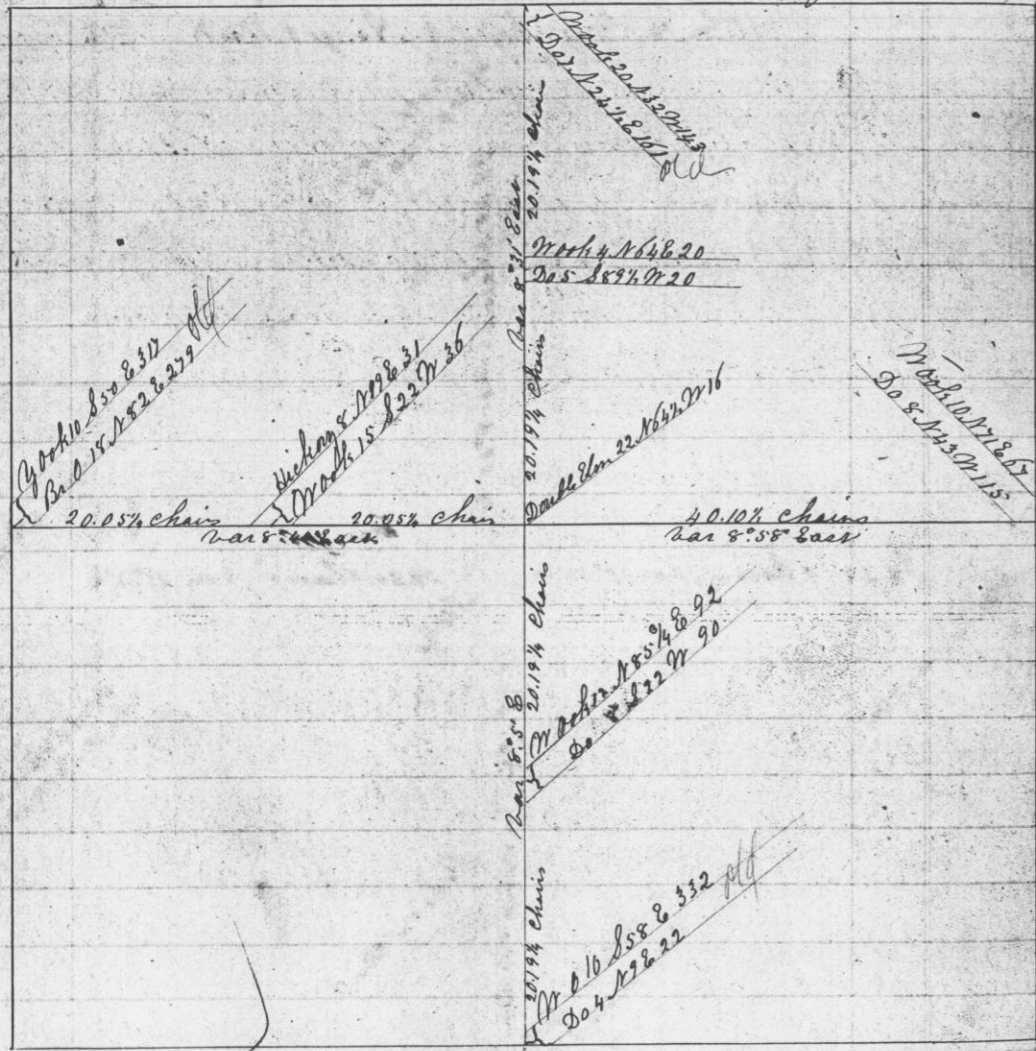

I hereby certify that the above is a correct copy of the original notes of said survey.
 Recorded Sep 6th 1854.
 John G. Clark
 County Surveyor

Survey made for William J. Ennor by Solomon Goodrich Deputy County Surveyor August 21st 1854 lying in the N.E. 1/4 of S.W. 1/4 of Section 26 Township 3 North Range 3 West.

Commencing at a point on the Platteville & Potosi Road 5.85 chains North of 116 Section corner South of center of said section. Thence South at a variation of 8° 14' East 1.85 chains to 116 Section corner Bearing North 16° 53' W 118 links. B. 10.10 S 64° E 50 links. Thence West variation 8° 22' East ^{10.054} 46.5 chains. Thence North variation 8° 14' East 1.30 chains to the aforesaid Road. Thence bearing 9° 17' E N 67° E ^{11.03 Ch} 3.16 chains along said Road to place of beginning containing ⁵⁷ 3700 rods 3 5700 rods.

A true Record of notes of said Survey
 Recorded Sep 6th 1854
 Attest
 John G. Clark
 County Surveyor

Survey made for William J. Ennor of a tract lying in the N.E. 1/4 of S.W. 1/4 of Section 26 Township 3 North Range 3 West by Solomon Goodrich Deputy County Surveyor August 21st 1854.

Commencing at a point on the Potosi and Platteville Road 10.054 chains West and 1.50 chains North of 116 Section corner South of center of said section. Thence South variation 8° 14' East 1.20 chains to 116 Section corner. Thence West bearing 8° 22' East ^{2.55} 3.00 chains to Potosi & Platteville Road. Thence bearing 9° 17' E N 67° E 3.16 chains along said Road to the place of beginning containing ⁵⁷ 3700 rods 30 9100 rods.

A true Record of notes of said Survey.
 Attest
 John G. Clark
 County Surveyor
 Recorded Sep 11th 1854