



Survey made in Section 18 Township 6 North Range 4 West June 2nd 1854 by Solomon Goodrich Deputy County Surveyor of the Co. of S.E. for Mellen Noyes Austin Noyes Sewell Noyes Chairmen
 Section 18 Township 6 North Range 4 West.

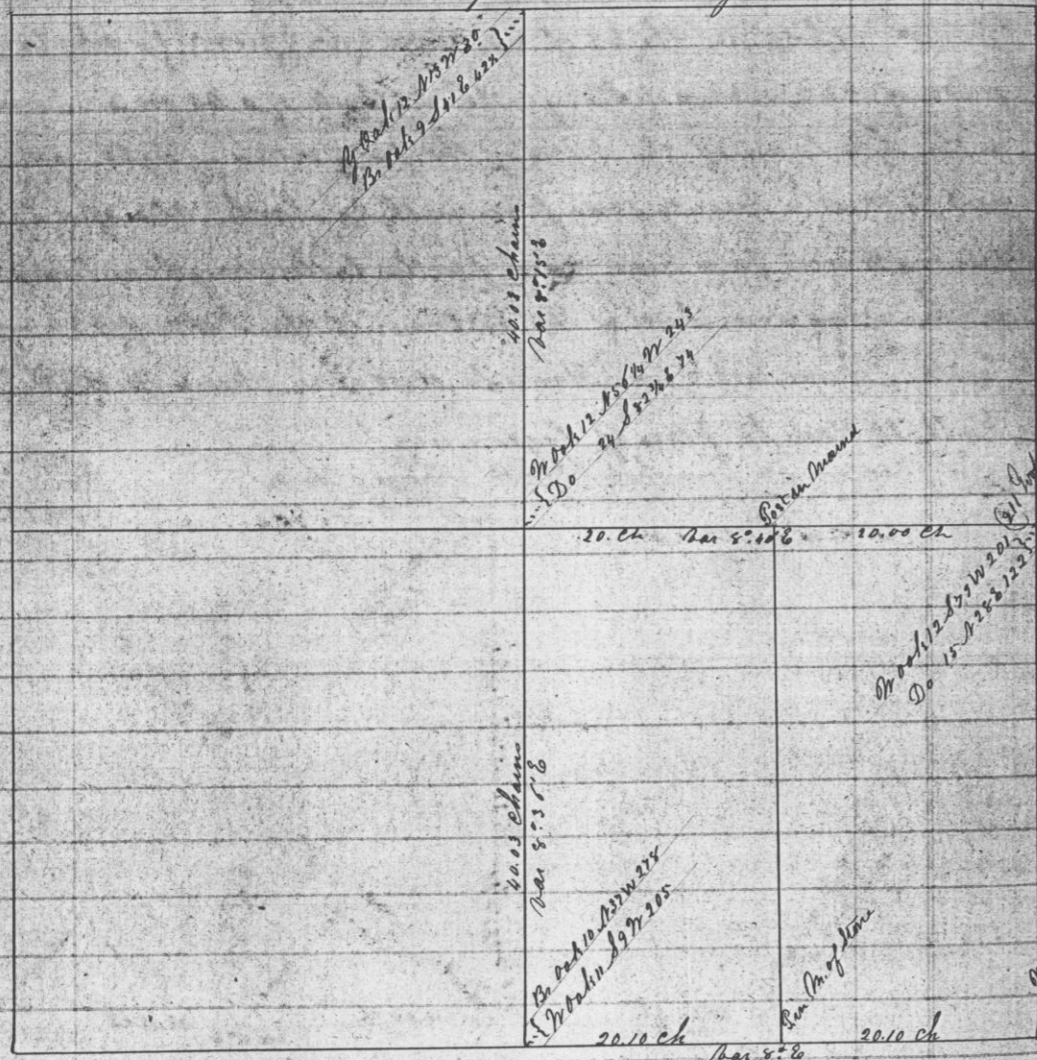

A true record of notes and diagrams of said survey
 Recorded Sept 26th 1854
 Attest John G. Clark County Surveyor

Survey made in Section 17 Township 6 North Range 4 West of the 1st P.M. June 2nd 1854 by Solomon Goodrich Deputy County Surveyor of the N.W. for Austin Noyes of the S.E. for Sewell Noyes Mellen Noyes & Martin Sewell Chairmen.
 Section 17 Township 6 North Range 4 West.

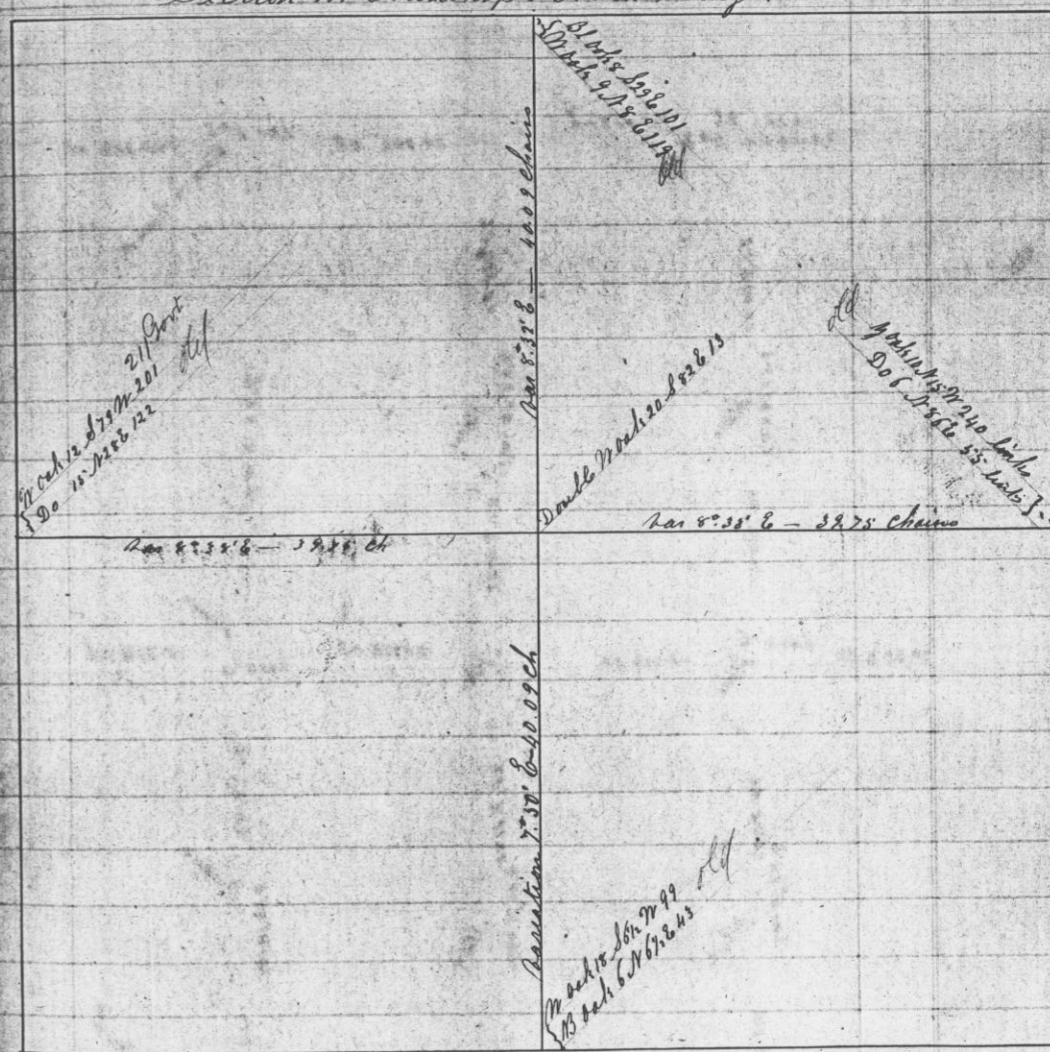

A true record of notes & diagrams of said survey
 Recorded Sept 26th 1854
 Attest John G. Clark County Surveyor